

Chickasaw Co. Recorder  
 Cindy Messersmith  
**Fee Book 2007-0968**  
 05/14/2007 61024AM  
 SCC SEC COR CERT  
 Book: Page: # Pages: 1  
 Total Fees: \$7.00

Herold - Reeks Surveying, 25 1/2 East Main Street, Suite 204, New Hampton, IA 50659, Ph. 641-394-2125

**UNITED STATES PUBLIC LAND SURVEY CORNER CERTIFICATE**

Land Survey Monuments situated in:

Section 2, Township 94 North, Range 13 West of the Fifth Principal Meridian,  
 Chickasaw County, Iowa. Previously recorded in 1.} None  
2.} None  
 in County Recorder's Office.

(Show reason for preparing this certificate, the evidence and detailed procedures used in establishing the corner positions and monumentation found or placed.)


Monument Description and Remarks:

1.} SW Corner NW 1/4-NE 1/4 Section 2-94-13, Set 1/2"Ø rebar w/2"Ø aluminum cap PLS 15525 by single proportion between the calculated Center and the N 1/4 Corner.

2.} SW Corner NE 1/4-NE 1/4 Section 2-94-13, Set 1/2"Ø rebar w/2"Ø aluminum cap PLS 15525 at the Intersection of the Quarter-Quarter Section Lines, after the standard subdivision of the Fractional NE 1/4 of the Section.

**PLAN - VIEW**

(Show a minimum of three reference ties to durable physical objects, relevant monuments and physical conditions that will enable recovery of the corner.)

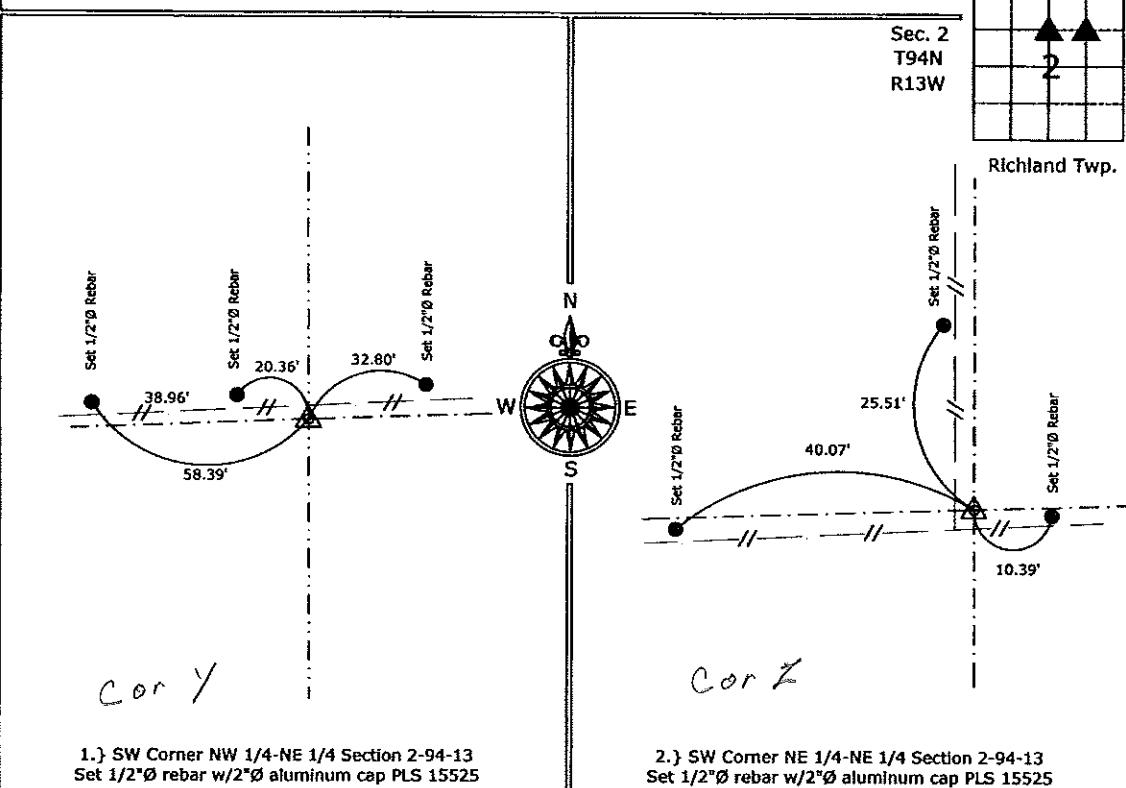

I hereby certify that this land surveying document was prepared and the related survey work was performed by me or under my direct personal supervision and that I am a duly licensed Land Surveyor under the laws of the State of Iowa.  
 Paul R. Herold 5-12-07

Paul R. Herold Date:

License number 15525

My license renewal date is December 31, 2008.  
 Sheets covered by this seal: Sheet P1

**List Corners to be Indexed**

Corners	Section	Twp.	Range
SW-NW-NE	2	94	13
SW-NE-NE	2	94	13

Project Number: 2007-033

FB: Chickasaw County 1, Pgs. 13-20