

Section 3-94-14  
As referred to in  
Engr. the Book

Chickasaw Co. Recorder  
Cindy Messersmith  
**Fee Book 2007-0733**  
04/16/2007 01143AM  
SCC SEC COR CERT  
Book: Page: # Pages: 1  
Total Fees: \$7.00

Herold - Reicks Surveying, 25 1/2 East Main Street, Suite 204, New Hampton, IA 50659, Ph. 648-394-2725

### UNITED STATES PUBLIC LAND SURVEY CORNER CERTIFICATE

Land Survey Monuments situated in:

Section 3 10, Township 94 North, Range 14 West of the Fifth Principal Meridian,  
Chickasaw County, Iowa. Previously recorded in 1.) None  
in County Recorder's Office. 2.) Bk. 169, Pg. 465

(Show reason for preparing this certificate, the evidence and detailed procedures used in establishing the corner positions and monumentation found or placed.)


Monument Description and Remarks:

1.) NE Corner Section 10-94-14, Set 1/2"Ø rebar w/2"Ø aluminum cap PLS 15525 at the center of the intersection of 260th Street and Durham Avenue.

2.) E 1/4 Corner Section 10-94-14 Fd. 60d Nail from the previous Section Corner Certificate, removed and Set 1/2"Ø rebar w/2"Ø aluminum cap PLS 15525 as a more substantial monument.


### PLAN - VIEW

(Show a minimum of three reference ties to durable physical objects, relevant monuments and physical conditions that will enable recovery of the corner.)

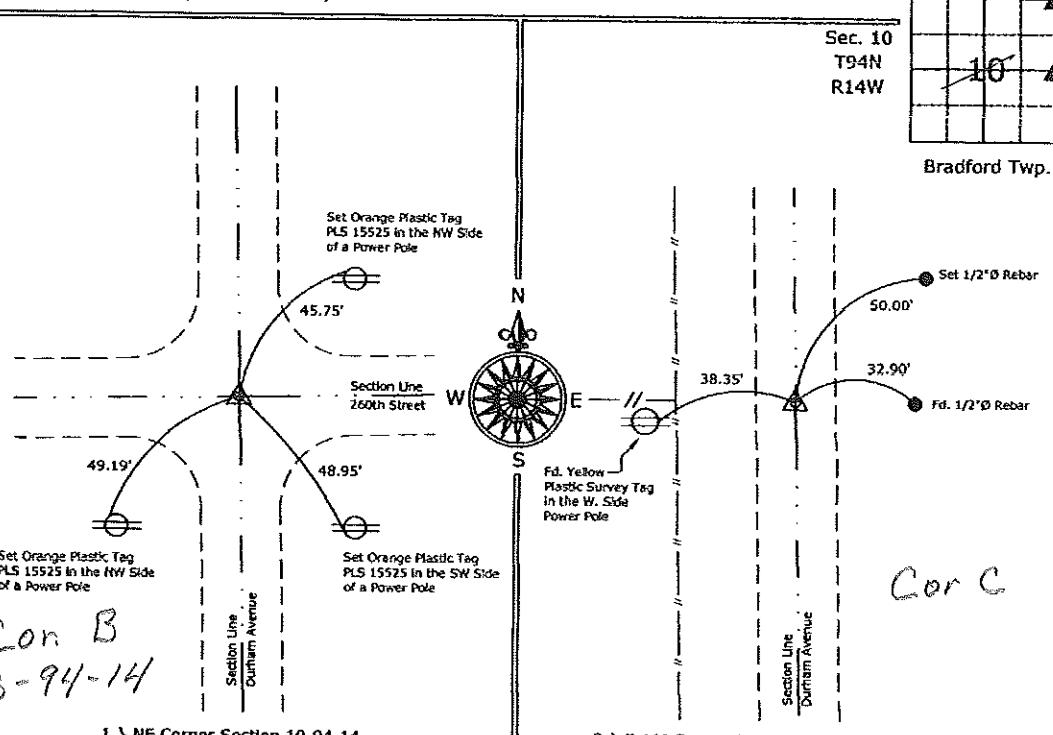

1.) NE Corner Section 10-94-14  
Set 1/2"Ø rebar w/2"Ø aluminum cap PLS 15525

2.) E 1/4 Corner Section 10-94-14 Fd. 60d Nail,  
Set 1/2"Ø rebar w/2"Ø aluminum cap PLS 15525

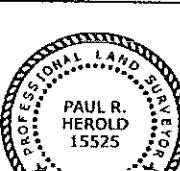

I hereby certify that this land surveying document was prepared and the related survey work was performed by me or under my direct personal supervision and that I am a duly licensed Land Surveyor under the laws of the State of Iowa.

*Paul R. Herold* 4-16-07

Paul R. Herold

Date:

License number 15525

My license renewal date is December 31, 2008.  
Sheets covered by this seal: Sheet P1

#### List Corners to be Indexed

Corners	Section	Twp.	Range
NE	10	94	14
E 1/4	10	94	14

Project Number: 2007-035

FB: Chickasaw County 1, Pgs. 9-10

File: S1 Projects\2007\2007-035\img\2007-035.dwg, 4/16/2007 8:16:03 AM