

*Cor. H1  
 1-94-14  
 As referred to  
 in Engr. Tie Book*

*Harold - Reicks Surveying, 25 1/2 East Main Street, Suite 204, New Hampton, IA 50659, Ph. 641-394-2725*

**UNITED STATES PUBLIC LAND SURVEY CORNER CERTIFICATE**

Land Survey Monuments situated in Section 12, Township 94 North, Range 14 West of the Fifth Principal Meridian, Chickasaw County, Iowa. Not previously recorded in the County Recorder's office.

This certificate is being prepared in compliance with Iowa Code Chapter 355.11 because:


- There is no certificate on file for this corner.
- There are no longer three valid ties of record.
- There are changes to reference ties of record.
- There is change of monumentation of record.
- To clarify description of record monument (ties).

**Monument Description and Remarks:**

- 1.) NW Corner of the NE 1/4-NW 1/4: Set 5/8"Ø rebar with 2"Ø aluminum cap PLS 19211 equidistant and online between the NW Corner and the North 1/4 Corner.
- 2.) NW Corner of the NE 1/4-SW 1/4: Set 5/8"Ø rebar with 2"Ø aluminum cap PLS 19211 equidistant and online between the West 1/4 Corner and the Center of the Section.

**PLAN - VIEW**

(Show a minimum of three reference ties to durable physical objects, relevant monuments and physical conditions that will enable recovery of the corner.)

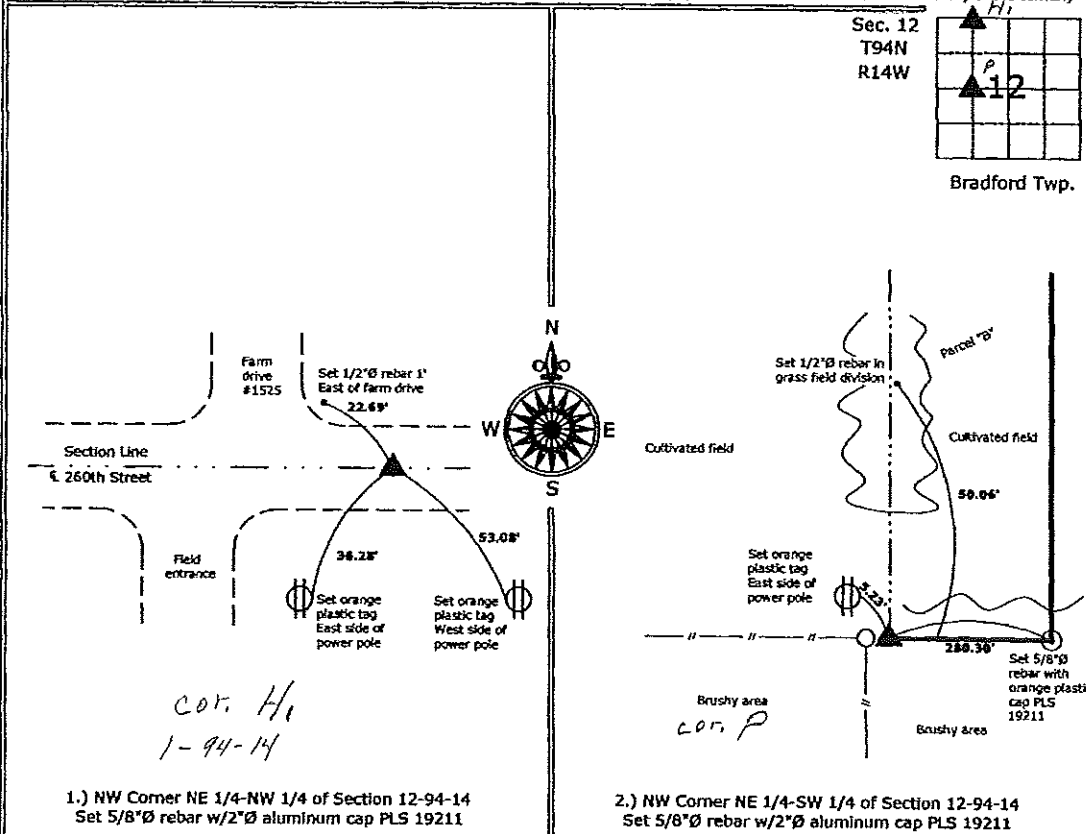

*Cor. H1  
 1-94-14*

*Brushy area  
 Cor. P*

1.) NW Corner NE 1/4-NW 1/4 of Section 12-94-14  
 Set 5/8"Ø rebar w/2"Ø aluminum cap PLS 19211

2.) NW Corner NE 1/4-SW 1/4 of Section 12-94-14  
 Set 5/8"Ø rebar w/2"Ø aluminum cap PLS 19211



I hereby certify that this land surveying document was prepared and the related survey work was performed by me or under my direct personal supervision and that I am a duly licensed Land Surveyor under the laws of the State of Iowa.  
*Kirk D. Reicks* 4-2-09  
 Kirk D. Reicks Date:  
 License number 19211  
 My license renewal date is December 31, 2010.  
 Sheets covered by this seal: Individual sheet only

List Corners to be Indexed			
Corners	Section	Twp.	Range
NW-NE-NW	12	94	14
NW-NE-SW	12	94	14

Project Number: 2009-025  
 FB: Chickasaw County 3, Pgs. 27-28

File:33 \Projects\2009\2009-025\dwg\2009-025.dwg, 4/1/2009 2:18:22 PM