

2005-2159

Lee O. Gallentine LS, Ryken Engineering, 711 Park Ave, Ackley, IA 50801 - Ph 641-847-3273 Fax 641-847-2303

### UNITED STATES PUBLIC LAND SURVEY CORNER CERTIFICATE

OF  
Land Survey Monuments situated in Section 12, Township 94 North, Range 14 West, of the Fifth Principal Meridian, Chickasaw County, Iowa,  
Previously recorded in Not Applicable in County Recorder's Office

(Show reason for preparing this certificate, the evidence and detailed procedures used in establishing the corner positions and monumentation found or set.)

#### Monument Description and Remarks:

SE Cor SW $\frac{1}{4}$  SW $\frac{1}{4}$ -History of Corner

No available record indicates that this corner was ever monumented.


Corner Recovery- Searched 4.0'± area around a point equidistance between SW Cor and S $\frac{1}{2}$  Cor with metal detector and found nothing. Since no monument can be located, set 'Survey Mark' nail flush in ACC at point equidistance between SW Cor and S $\frac{1}{2}$  Cor (see plat filed with this corner certificate for measurements) and used it as the correct corner. Nail is 6.8'± N of centerline joint of ACC road E-W and 7.0'± W of fence line N. All ties are plumb distance unless indicated otherwise.

This certificate is being prepared because there are no certificates on file for this corner and this corner was used for a survey in this section for Evelyn G. Thompson.

#### Plan View

(Show a minimum of three reference ties to durable physical objects, relevant monuments, and physical conditions that will enable recovery of the corner.)


SE Cor SW $\frac{1}{4}$  SW $\frac{1}{4}$

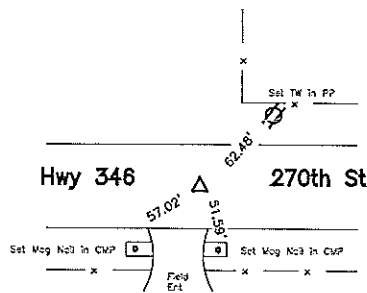

Cor H<sub>1</sub>

#### Legend

- BC = Nail w/ Bottle Cap
- BP = Brace Post
- CP = Corner Post
- CM = 4" Sq Concrete Monument w/ 1/2" Ø Iron rod in center (tie to rerod)
- CX = Cut X
- GP = Gate Post
- GPW = Nail w/ Green Plastic Washer
- PP = Power Pole
- RH = Red Hood (Nail in wire)
- SFP = Steel Fence Post
- R/W = Nail w/ Reflective Round Washer
- R/W = Iron ROW Rod
- SM = Nail w/ Yellow Plastic Survey Marker
- SW = Nail w/ Square Metal Washer
- TP = Telephone Pedestal
- TW = Nail w/ Round Metal Washer
- WFP = Wood Fence Post
- X = X Nails

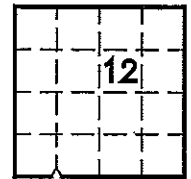

List Corners to be Indexed			
Corners	Section	Twp	Range
SE Cor SW $\frac{1}{4}$ SW $\frac{1}{4}$	12	T94N	R14W



I hereby certify that this land surveying document was prepared and the related survey work was performed by me or under my direct personal supervision and that I am a duly licensed Land Surveyor under the laws of the State of Iowa.

*Lee O. Gallentine*  
LEE O. GALLETINE, LS

Date: Aug 5, 2005 License number: 15745  
My license renewal date is December 31, 2006

Pages or sheets covered by this seat: 1