

Instrument #: 2024-0678  
 05/14/2024 03:56:42 PM Total Pages: 1  
 SCC SECTION CORNER CERTIFICATES  
 Recording Fee: \$ 7.00  
 Shirley Troyna, Recorder, Chickasaw County Iowa



Prepared by & Return to: Kirk D. Reicks, HRS, LLC, 10 East Main Street, New Hampton, IA 50659, Phone 641-394-2725

### United States Public Land Survey Corner Certificate

Land Survey Monument situated in  
 Section 12, Township 94 North, Range 14 West of the Fifth Principal Meridian, Chickasaw County, Iowa.  
 On file in Document #2005-2159 in the County Recorder's Office.

This certificate is being prepared in compliance with Iowa Code Chapter 355.11 because:

- There is no certificate on file for this corner.
- There are no longer three valid ties of record.
- There are changes to reference ties of record.
- There is change of monumentation of record.
- To clarify description of record monument (ties).


**Monument Description and Remarks:**

**Southeast Corner of the SW 1/4 - SW 1/4:**

Set 1"Ø Bronze Survey Marker equidistant and online between the Southwest and South 1/4 Corners of said Section with information obtained from the previously recorded Section corner certificate. The previous Monument (Survey Mark Nail) was covered after an HMA overlay project.

### Plan View - Not to Scale

(Show a minimum of three reference ties to durable physical objects, relevant monuments and physical conditions that will enable recovery of the corner.)

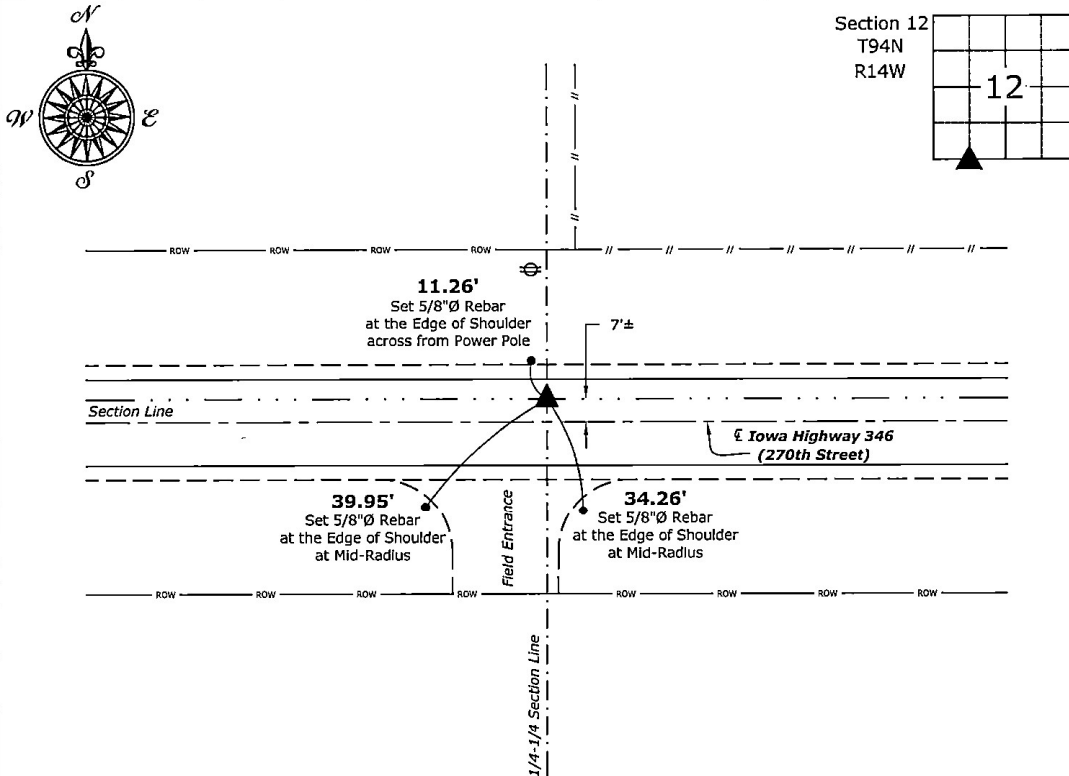

COR E1  
 13-94-14

**Southeast Corner of the SW 1/4 - SW 1/4 of Section 12-94-14**  
 Set 1"Ø Bronze Survey Marker PLS 19211



I hereby certify that this land surveying document was prepared and the related survey work was performed by me or under my direct personal supervision and that I am a duly licensed Land Surveyor under the laws of the State of Iowa.  
*Kirk D. Reicks* 5-13-2024  
 Kirk D. Reicks Date:  
 License number 19211  
 My license renewal date is December 31, 2024.  
 Sheets covered by this seal: Individual sheet only

List Corner to be Indexed			
Corner	Section	Township	Range
SE-SW-SW	12	94	14
Project Number: 2024-027			
FB: Chickasaw 12, Page(s) 59-60			

File: S:\\_Projects - NHO\County Control Systems - NHO\CHICKASAW\CHICK-39\2024.dwg - 2024.dwg, 5/13/2024 12:07:44 PM