


COUNTY ENGINEER'S SECTION CORNER PRESERVATION RECORD

LAND SURVEY MONUMENT LOCATED IN SECTION 14, TOWNSHIP 94 N
NORTH, RANGE 14 W, OF THE 5TH P.M. Chickasaw COUNTY, IOWA
PREVIOUSLY RECORDED Book 2010-1466

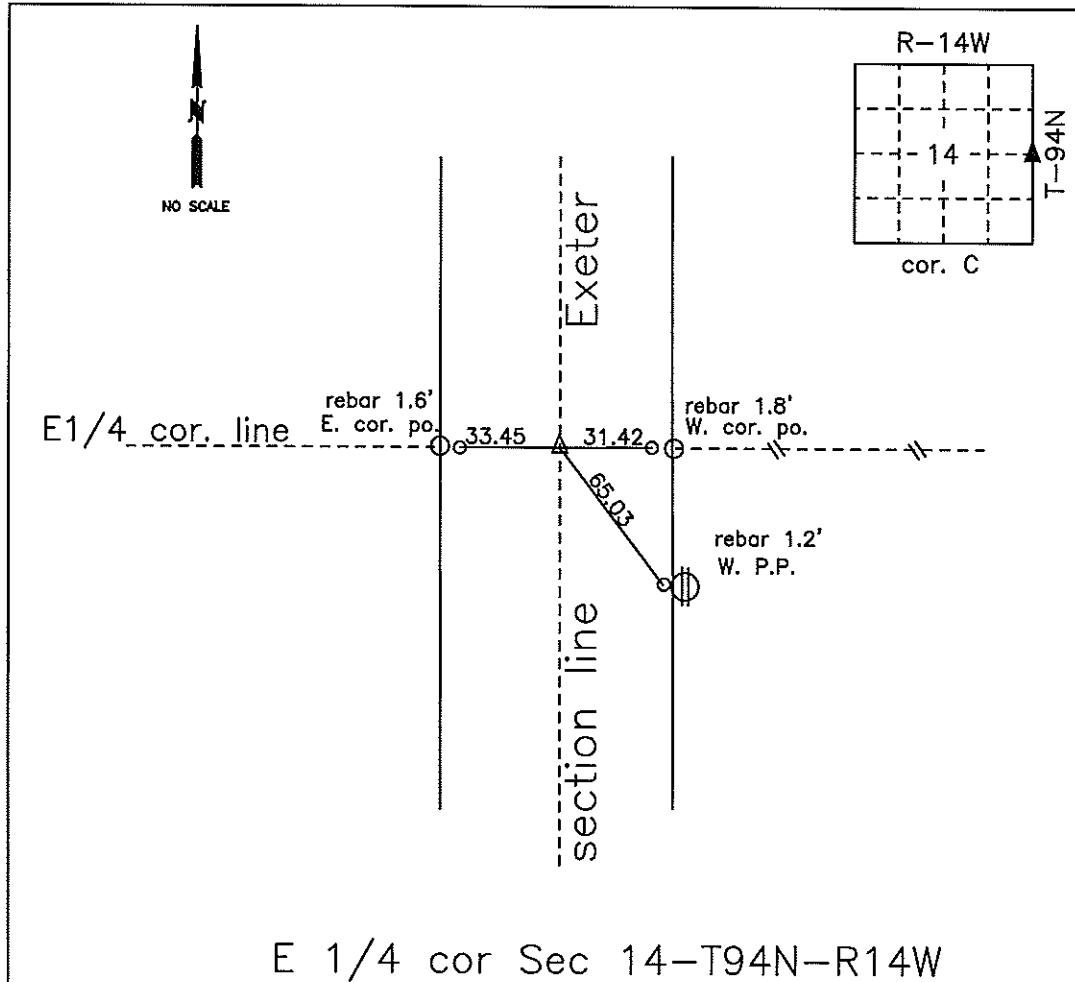

MONUMENT DESCRIPTION AND NARRATIVE Using county engineer ties, found 5/8" iron
pin in center of the road and on fence line to east and west

All ties are GPS surveyed.

I AM NOT A REGISTERED LAND SURVEYOR UNDER THE LAWS OF THE STATE OF IOWA

JIM FOSTER CHICKASAW CO. DATE: 7/10/13

CHICKASAW CO. RECORDER
Cindy Messersmith
Fee Book 2010-1466
09/29/2010 @0918AM
SCC SEC COR CERT
Book: Page: # Pages: 1
Total Fees: \$9.00

STEVE BUSSE P.O. BOX 241 508 ELM ST. ALLISON, IOWA 50602 319-267-2519

UNITED STATES PUBLIC LAND SURVEY CORNER CERTIFICATE
OF



LAND SURVEY MONUMENTS SITUATED IN SECTION NO. 14, TOWNSHIP NO. 94 NORTH, RANGE
NO. 14 WEST OF THE FIFTH PRINCIPAL MERIDIAN, CHICKASAW COUNTY, IOWA.
PREVIOUSLY RECORDED IN N/A.

(SHOW REASON FOR PREPARING THIS CERTIFICATE, THE EVIDENCE AND DETAILED PROCEDURES USED IN ESTABLISHING THE
CORNER POSITIONS AND MONUMENTATION FOUND OR PLACED.)
MONUMENT DESCRIPTION AND REMARKS:


THIS CERTIFICATE IS BEING PREPARED AS ONE IS NOT RECORDED. USING TIES FROM COUNTY ENGINEER
FOUND 5/8" SMOOTH IRON PIN IN CENTER OF ROAD AND ON FENCE LINE TO EAST AND WEST. PIN WAS
BENT OVER ON TOP. DUG DOWN AND REMOVED PIN. SEARCHED AREA WITH LOCATOR BUT FOUND
NOTHING. CUT BENT PORTION OF PIN OFF AND REPLACED IN ORIGINAL HOLE.

PLAN VIEW

(SHOW A MINIMUM OF THREE REFERENCE TIES TO DURABLE PHYSICAL OBJECTS, RELEVANT MONUMENTS AND PHYSICAL
CONDITIONS THAT WILL ENABLE RECOVERY OF THE CORNER.)

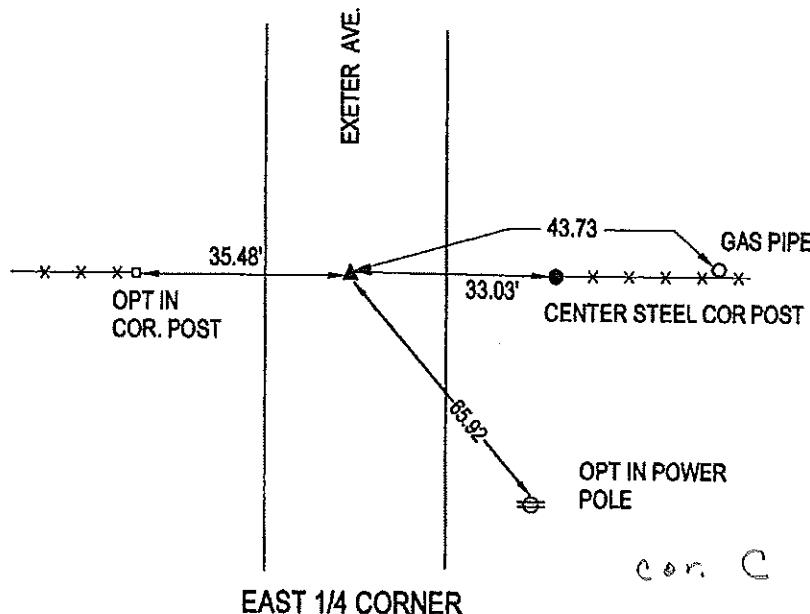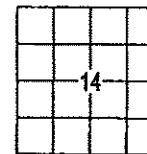

C or. C

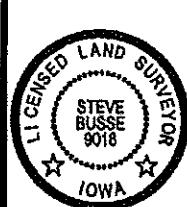

I HEREBY CERTIFY THAT THIS LAND SURVEYING DOCUMENT
WAS PREPARED AND THE RELATED SURVEY WORK WAS
PERFORMED BY ME OR UNDER MY DIRECT PERSONAL
SUPERVISION AND THAT I AM A DULY LICENSED LAND
SURVEYOR UNDER THE LAWS OF THE STATE OF IOWA.

Steve Busse

STEVE BUSSE
LICENSING NUMBER 9018

MY LICENSE RENEWAL DATE IS DECEMBER 31, 2010
PAGES OR SHEETS COVERED BY THIS SEAL

G.P. = 2" GAS PIPE
CONC MONU = CONCRETE MONUMENT W/ PIN & ALUM CAP
"X" NAILS = CROSS NAILS IN WOOD POST
OPT = PLASTIC TAG (O=ORANGE, Y=WHITE)
(00) RECORDED AS

LIST CORNERS TO BE INDEXED
CORNER SECTION TOWNSHIP RANGE

EAST 1/4 COR. 14 94 14