Instrument N: 2018-1911
i1/21/2018 09:43:44 AM Total Pages: 1
SCC SECTION CORNER CERTIFICATES
Recording Fee: \$ 7.00
Shirley Troyna, Recorder, Chickasaw County Iowa

Prepared by & Return to: Herold - Reicks Surveying, 10 East Main Street, New Hampton, 19 50659, Ph. 641-394-2725

United States Public Land Survey Corner Certificate

Land Survey Monument situated in

Section 15, Township 94 North, Range 14 West of the Fifth Principal Meridian, Chickasaw County, Iowa. On file in Document #2002-0748 in the County Recorder's office.

This certificate is being prepared in compliance with Iowa Code Chapter 355.11 because:



There is no certificate on file for this corner.

There are no longer three valid ties of record.

There are changes to reference tles of record.

There is change of monumentation of record.


☐ To clarify description of record monument (ties).

Monument Description and Remarks:

Southeast Corner NE 1/4-NE 1/4: Found Lead Plug and Cut "X" with information obtained from the previously recorded Section Corner Certificate. Reset 1"Ø Bronze Survey Marker PLS 19211 with coordinates obtained prior to highway reconstruction. Corner was reset in conjunction with Project No. FM-CO19(88)--55-19.

Plan View

(Show a minimum of three reference ties to durable physical objects, relevant monuments and physical conditions that will enable recovery of the corner.)

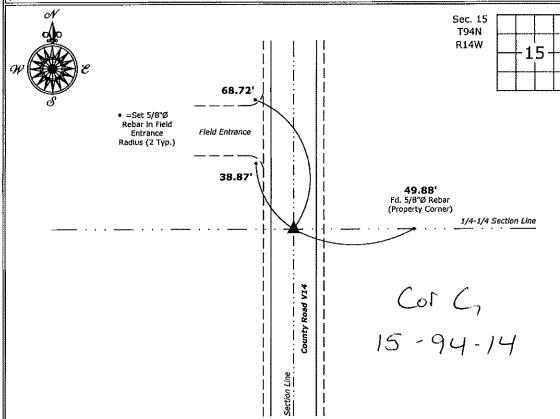

Southeast Corner NE 1/4-NE 1/4 of Section 15-94-14

S

Set 1"Ø Bronze Survey Marker PLS 19211



I hereby certify that this land surveying document was prepared and the related survey work was performed by me or under my direct personal supervision and that I am a duly licensed Land Surveyor under the laws of the State of Iowa.

Tanto 1-20-18 Kirk D. Reicks

| license number 19211 |
|--|
| My license renewal date is December 31, 2018. |
| Sheets covered by this seal: Individual sheet only |

| List Corner to be Indexed | | | | | |
|---------------------------|---------|--------------|--|--|--|
| Section | Twp. | Range | | | |
| 15 | 94 | 14 | | | |
| | Section | Section Twp. | | | |

Project Number: 2018-805 FB: Chickasaw 8, Pgs. 72

Control Systems\CHICKASAW\CHICK-46\CHICK-46.dwg, 11/20/2018 12:48:42 PM S:_C3D Projects\County

FILED 2002-0748 RECORDER'S OFFICE CHICKASAW COUNTY, 10WA

2002 MAR 22 RM 9 05

CIMDY HESSERSMITH COUNTY RECORDER

| TEKIPPE ENGINEERING, P.C., 128 S | th 15me Street Worl | Union Iowa 5217 | 5 Phone (56 | 3) 422-5131 |
|--|--|-------------------------|--|----------------------------|
| TEKIPPE ENGINEERING, P.C., 128 S | DITIC I AND CH | DIEV CODNE | אויים ליים ליים ליים ליים ליים ליים ליים | |
| UNITED STATES PU | | RVEI CORNE. | t Chitie. | ICATE |
| | OF | | 0.4 | 11 5 |
| Land Survey Monuments situat | ted in Section | $\frac{15}{}$, Townshi | P ———— | North, Range |
| | | | | |
| Previously recorded in | none (book, page, document numb | er, etc.) in | County Reco | order's Office. |
| (Show reason for preparing this certi- the corner positions and monumenta | ificate, the evidence a tion found or placed.) | nd detailed procedu | ires used in e | stanismig |
| Monument Description and Re- | marks: SE Corner | NE 1/4 - NE 1 | /4 Section | 15 T94N R14W |
| Found lead plug in PCC surfa | ce. Placed cut- | over plug. | | 11 V |
| E 1/4 Corner Section 15 T94N | R14W: Found lea | id plug in PCC | surface. P | laced cut-x |
| over plug. | | ion obtained fro | m a Surve | v and Plat |
| NOTE: Both Corners were for made by Thomas Craft record | ind with information | on Obtained It | order's Offic | re in |
| made by Thomas Craft record | March 24 1986 | saw country nee | oracr b onn | <u> </u> |
| Deeds Book 135, Page 483 on | | | Projec | t Number 02034.LS |
| | | VIEW 15941 | Florand EB. | 46I PG. 69-76 |
| (Show a minimum of three reference | e ties to durable phys | ical objects, relevan | nt monuments | and physical |
| conditions that will enable recovery | of the corner.) | | | |
| | . I | | Sec. 15 T94N | 15 |
| | 1 | | R14W | 1101 |
| | ! | | 4 | h-+ |
| | 1 | | Rd. V14) | |
| | 1/4-1/4 T Sec. Line | 1 | Rd | Bradford Twp. |
| | | | o . | • |
| | 1 | | | Set orange |
| 50.00' | 50.04' | | i je | plostic tag PLS 15525 |
| | Found 5/8"ø | * | Durham Ave. (Co. Section Line | top of wood fence post |
| — <i>"</i> 」\ | rebar | | Sec | |
| Found 5/8"¢ | | | | 51.58 |
| rebar w/yellow > \ | i 👠 | 50.56 | | |
| 7549 | 1 | Set orange | | 50.94 |
| | , ! | PLS 15525 | | · · · · · |
| Durham Ave. (Co. R | Set 1/2"ø | top of wood fence post | 1 1 | Set orange (|
| | \ [₽] - shoulder | } | 1 | PLS 15525 |
| \ \ \ \ \ \ \ \ \ \ \ \ \ \ \ \ \ \ \ | across from power pole | | | top of wood fence post |
| | 1/ | 1 | | 1 |
| Cor CI NAMES | i, | Cor C | | |
| . 0 | ! | () () | 1 [1 | |
| | | | | ' |
| SE Corner NE 1/4 - NE 1/4 Section | 15 T94N R14W | E 1/4 Corner Section | n 15 T94N R14 | W |
| Found lead plug. Placed cut—X | over plug. | Found lead plug | Placed cut-> | over plug. |
| | | 77-1 6 | | |
| I hereby certify that this land surveying document was prepared and the related survey work was Corners Section Twp. Range | | | | |
| AND performed by me or un | der my direct personal | COLUGIA BEC | A1411 1 1 1 1 1 1 1 1 1 1 1 1 1 1 1 1 1 | . wanke |
| supervision and that I supervision and the supervi | am a duly licensed Land s of the State of Iowa. | SE-NE-NE 1 | 5 941 | N 14W |

E 1/4

15

Filed

Paul R Herold 3-21-02

My license renewal date is December Si, 2002. Sheets covered by this seal: Individual

License number 15525

94N

14W

4-1-02 County Engineers

