

Prepared by & Return to: Harold - Reicks Surveying, 10 East Main Street, New Hampton, IA 50659, Ph. 641-394-2725

### United States Public Land Survey Corner Certificate

Land Survey Monument situated in  
 Section 16, Township 94 North, Range 14 West of the Fifth Principal Meridian, Chickasaw County, Iowa.  
 Not on file in the County Recorder's office.

This certificate is being prepared in compliance with Iowa Code Chapter 355.11 because:


- There is no certificate on file for this corner.
- There are no longer three valid ties of record.
- There are changes to reference ties of record.
- There is change of monumentation of record.
- To clarify description of record monument (ties).

#### Monument Description and Remarks:

**Southwest Corner NW 1/4-SW 1/4:** Found Mag Nail Shaft with information obtained from a Survey and Plat recorded as Doc. #2003-2744, on file in the Chickasaw County Recorder's office, New Hampton, IA. Replaced with Survey Mark Nail with Stainless Steel Washer PLS 19211.

### Plan View

(Show a minimum of three reference ties to durable physical objects, relevant monuments and physical conditions that will enable recovery of the corner.)

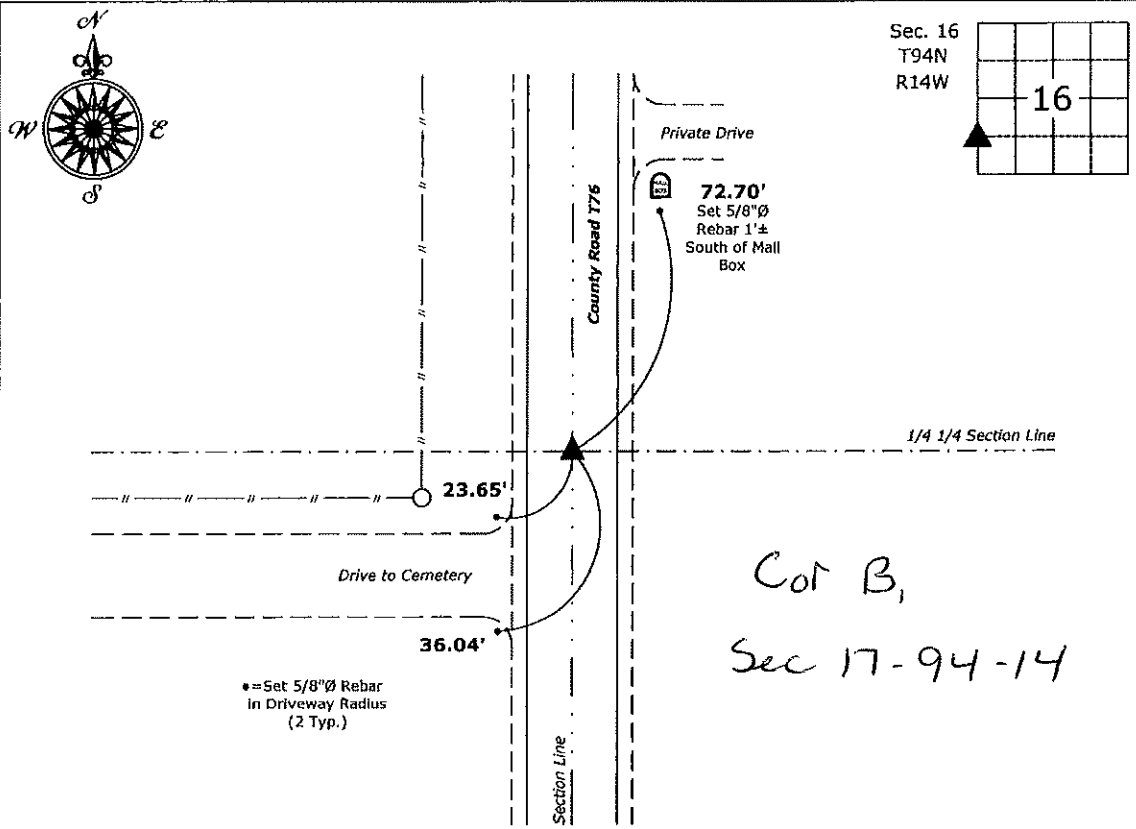

**Southwest Corner NW 1/4-SW 1/4 of Section 16-94-14**  
 Found Mag-Nail shaft replaced with Survey Mark Nail with Stainless Steel Washer PLS 19211



I hereby certify that this land surveying document was prepared and the related survey work was performed by me or under my direct personal supervision and that I am a duly licensed Land Surveyor under the laws of the State of Iowa.  
*Kirk D. Reicks* 11-2-18  
 Kirk D. Reicks Date:  
 License number 19211  
 My license renewal date is December 31, 2018,  
 Sheets covered by this seal: Individual sheet only

List Corner to be Indexed			
Corner	Section	Twp.	Range
SW-NW-SW	16	94	14
Project Number: 2018-160			
FB: Chickasaw 9, Pgs. 24-25			