

Chickasaw Co. Recorder
 Cindy Messersmith
Fee Book 2012-0867
 05/03/2012 @0412PM
 SCC SEC COR CERT
 Book: Page: # Pages: 1
 Total Fees: \$7.00

Prepared by & Return to Herold - Racks Surveying, 10 East Main Street, New Hampton, IA 50659, Ph. 641-394-2725

UNITED STATES PUBLIC LAND SURVEY CORNER CERTIFICATE

Land Survey Monuments situated in Section 17, Township 94 North, Range 14 West of the Fifth Principal Meridian, **Chickasaw County, Iowa**. 1.) Previously recorded in **Bk. 172, Pg. 262**, 2.) Not previously recorded in the County Recorder's office.

This certificate is being prepared in compliance with Iowa Code Chapter 355.11 because:

- {
- There is no certificate on file for this corner.
 - There are no longer three valid ties of record.
 - There are changes to reference ties of record.
 - There is change of monumentation of record.
 - To clarify description of record monument (ties).


Monument Description and Remarks:

1.) **Northeast Corner NW 1/4-NW 1/4:** Set 5/8"Ø Rebar w/2"Ø Aluminum Cap, PLS 15525, Equidistant and on line between the Northwest Corner and the North Quarter Corner of Section 17.

2.) **Southwest Corner NW 1/4-NW 1/4:** Set 5/8"Ø Rebar w/2"Ø Aluminum Cap, PLS 15525, Equidistant and on line between the Northwest Corner and the West Quarter Corner of Section 17, the previous monument was removed from the construction of a water main and fire hydrant replacement, all of the previous ties are missing.

PLAN - VIEW

(Show a minimum of three reference ties to durable physical objects, relevant monuments and physical conditions that will enable recovery of the corner.)

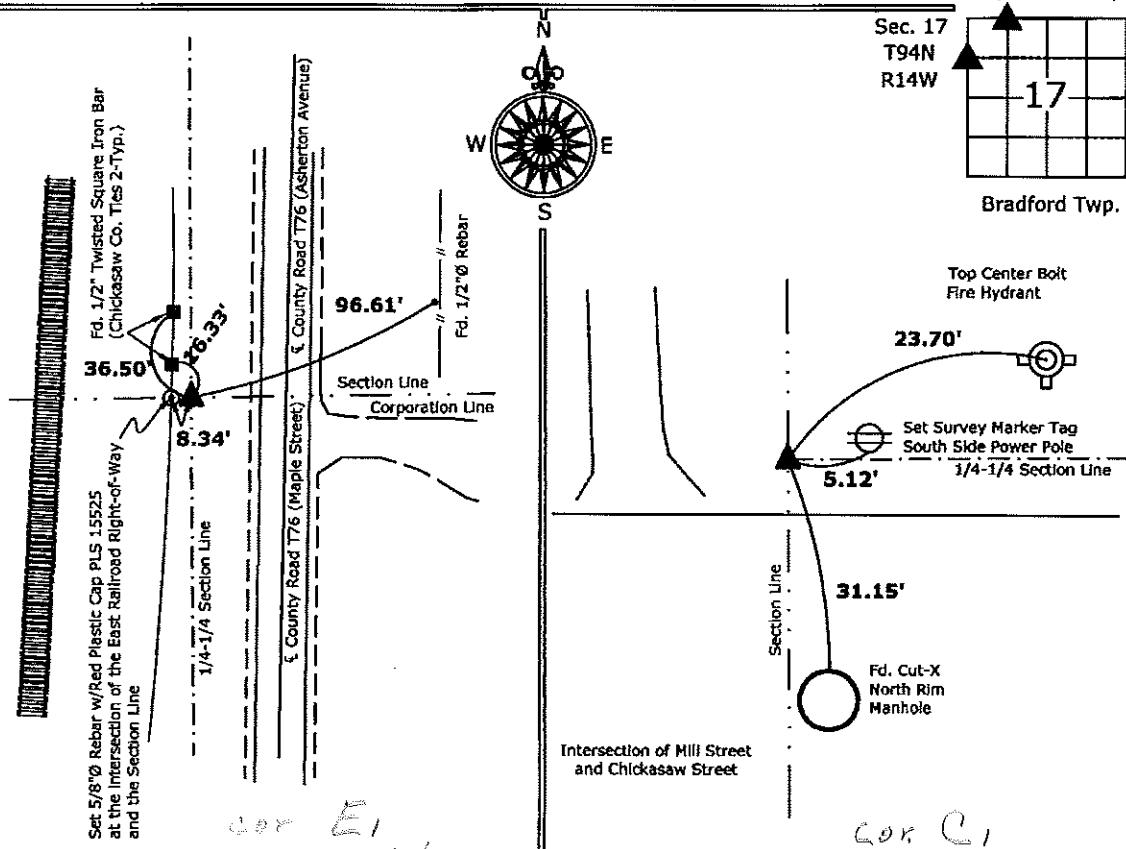

1.) **NE Corner NW 1/4-NW 1/4 Section 17-94-14**
 Set 5/8"Ø rebar w/2"Ø aluminum cap PLS 15525

2.) **SW Corner NW 1/4-NW 1/4 Section 17-94-14**
 Set 5/8"Ø rebar w/2"Ø aluminum cap PLS 15525



I hereby certify that this land surveying document was prepared and the related survey work was performed by me or under my direct personal supervision and that I am a duly licensed Land Surveyor under the laws of the State of Iowa.

Paul R. Herold 5-3-12

List Corners to be Indexed

Corners	Section	Twp.	Range
NE-NW-NW	17	94	14
SW-NW-NW	17	94	14