

Section 8-94-14  
As referred to in  
Engr. Tie Back

2005 07/12  
04-20-05

PREPARED BY: BRIAN J. DIEHL LS 13644 WHKS & CO. 1412 6th ST. S.W. MASON CITY, IOWA 50401 -- (641) 423-8271

SLSI 9-90


UNITED STATES PUBLIC LAND SURVEY CORNER CERTIFICATE

Land Survey Monuments Situated in Section 17 <sup>8</sup>, Township 94 N, Range 14 W, of the Fifth Principle Meridian, CERRO GORDO Chick. County, Iowa  
Previously Recorded in NO RECORD in County Recorder's Office

(Show reason for preparing this certificate, the evidence and detailed procedures used in establishing the corner positions and monumentation found or placed.)

Monument Description and Remarks: NW COR. NE1/4 NE1/4 - SET IRON T-BAR MONUMENT WITH L.S. CAP 13644 0.3' DEEP IN GRAVEL ROAD.

PLAN-VIEW  
(Show a minimum of three reference ties to durable physical objects, relevant monuments and physical conditions that will enable recovery of the corner.)

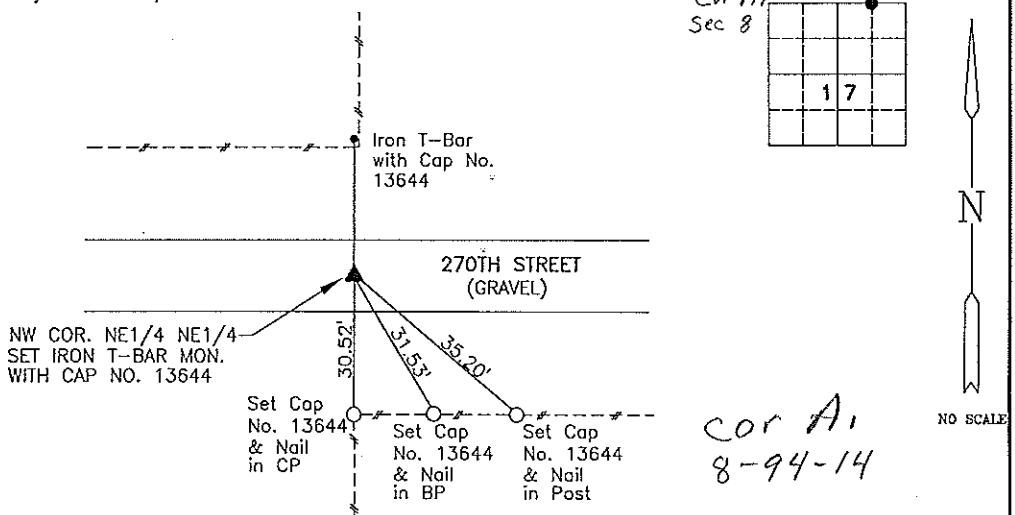

I hereby certify that this land surveying document was prepared and the related survey work was performed by me or under my direct personal supervision and that I am a duly licensed Land Surveyor under the laws of the State of Iowa.


  
Brian J. Diehl

Apr. 13, 2005

License number 13644.

My license renewal date is December 31, 2005

Sheets covered by this seal: 1

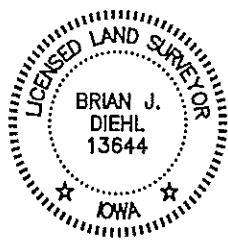

WHKS & co.

ENGINERS — PLANNERS — LAND SURVEYORS —  
1412 — 6th STREET S.W. P.O. BOX 1467 MASON CITY, IOWA 50402-1467  
641-423-8271