

Chickasaw, COUNTY
LAND SURVEY MONUMENT RECORD

Sec 18 T 94 N R 14 W

Cor. V

All items to be completed. Please print or type.

1. Type of Monument
(check one)

Section Corner Bench Mark

Quarter Corner Other _____

NW cor SW 1/4 SW 1/4

2. Description of Evidence found and location. NW cor SW 1/4 SW 1/4


Set at midpoint between re-established NW 1/4 cor and SW cor of Section 18

3. Description of monument and/or accessories established by you to perpetuate the location of this point.

Set T-bar mon. and tied as shown in sketch at right.

D. BUSS
J. DEEVEY
D. ANDERSON

4. Sketch showing relative location of monument and reference points. Show supporting and/or contradictory evidence where applicable.

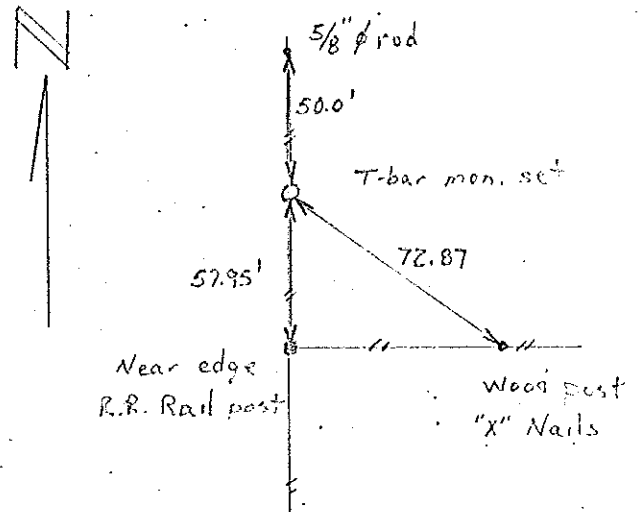

Date of Field Work 3/29/75

Signed David Buss
WHS & Co.