

COUNTY
LAND SURVEY MONUMENT RECORD

Sec 18 T 94 N R 14 W

COR. K

All items to be completed. Please print or type.

1. Type of Monument
(check one)

Section Corner Bench Mark

Quarter Corner Other _____

NW cor SE SW

2. Description of Evidence found and location. NW cor SE 1/4 SW 1/4

Set at proportional dist. E-W and N-S to 1874 survey plat of record.

3. Description of monument and/or accessories established by you to perpetuate the location of this point.


Set T-bar mon. and tied as shown in sketch at right.

D. BUSS

J. DEENY

D. ANDERSON

4. Sketch showing relative location of monument and reference points. Show supporting and/or contradictory evidence where applicable.

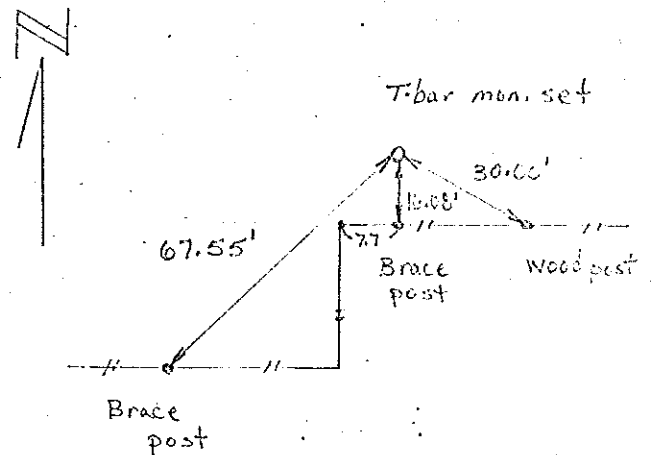

Date of Field Work 8/29/75

Signed David Buss
WHKS & Co.

All ties "X" Nails