

UNITED STATES PUBLIC LAND SURVEY CORNER CERTIFICATE

OF

Land Survey Monuments situated in Section 7, Township 94 North, Range 14 West, of the Fifth Principal Meridian, CHICKASAW County, Iowa. Previously recorded in Deed Book 158, Page 122 in County Recorder's Office. (book, page, document number, etc.)


(Show reason for preparing this certificate, the evidence and detailed procedures used in establishing the corner positions and monumentation found or placed.)

Monument Description and Remarks: SW Corner Section 7 T94N R7W: Found iron pipe over iron pin. The previous Section Corner Certificate has ties to a 60d nail that was set over this corner. The nail is now gone and the pipe is used as the corner.

SE Corner Section 7 T94N R7W: Found 1 1/2"Ø pipe, from surveys of record. The previous Section Corner Certificate incorrectly tied out a 1/4 - 1/4 corner in Section 18 T94N R14W (tie to South for SE corner this certificate).

PLAN - VIEW


(Show a minimum of three reference ties to durable physical objects, relevant monuments and physical conditions that will enable recovery of the corner.)

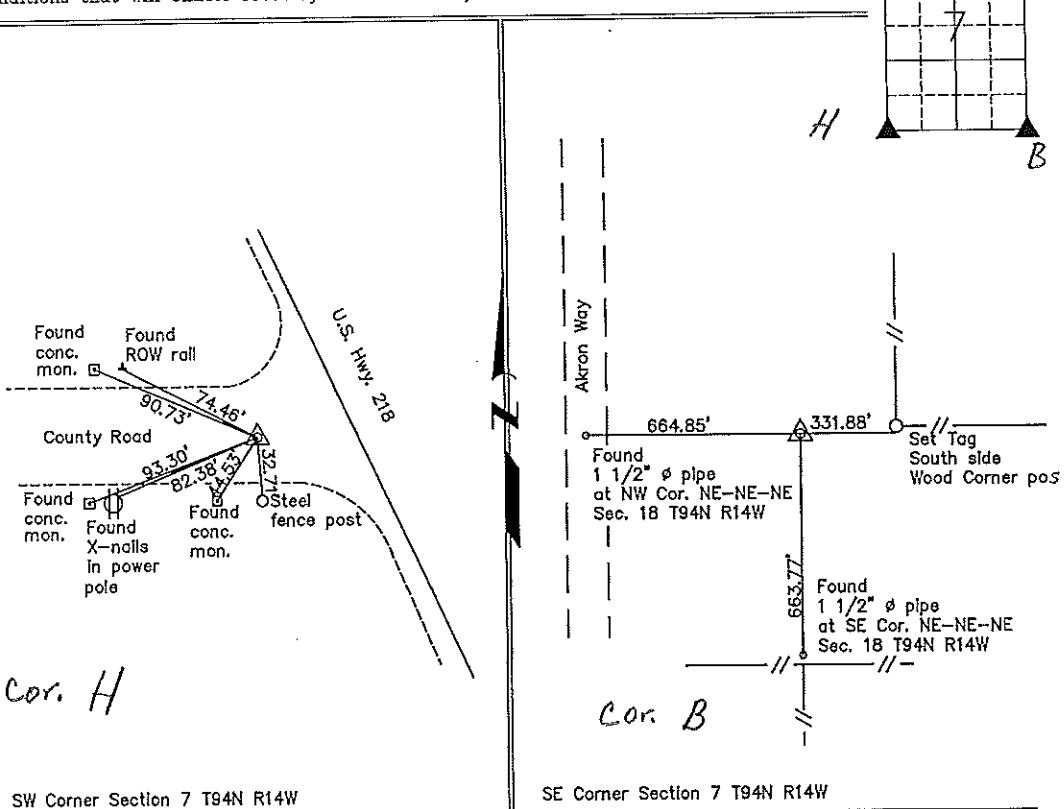

SW Corner Section 7 T94N R14W

SE Corner Section 7 T94N R14W

I hereby certify that this land surveying document was prepared and the related survey work was performed by me or under my direct personal supervision and that I am a duly licensed Land Surveyor under the laws of the State of Iowa.

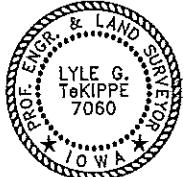

Lyle G. TeKippe 3-6-98
Lyle G. TeKippe
License number 7060
My license renewal date is December 31, 1998.
Sheets covered by this seal Individual

List Corners to be Indexed			
Corners	Section	Twp.	Range
SW	7	94N	14W
Cor. H	7	94N	14W
SE	7	94N	14W

*Cor. B - 7-94-14
Placed in Tie Book
3/23/98*

Section 7-94-11
As referred to in
Engr. Tic Book

TEKIPPE ENGINEERING, P.C. 128 South Vine Street, West Union, Iowa 52176 Phone (319) 422-5131

UNITED STATES PUBLIC LAND SURVEY CORNER CERTIFICATE

OF



Land Survey Monuments situated in Section 18, Township 94 North, Range 14 West, of the Fifth Principal Meridian, CHICKASAW County, Iowa. Previously recorded in none in County Recorder's Office.

(Show reason for preparing this certificate, the evidence and detailed procedures used in establishing the corner positions and monumentation found or placed.)

Monument Description and Remarks: Note: These two corners are
Quarter-Quarter-Quarter Section corners. Iowa Code does not require this Section
Corner Certificate. However, in order to find the NE Corner of Section 18 T94N R14W
(falls in cultivated field, 12" deep) it is imperative to have these corners.
They were found from surveys of record; both corners are 1 1/2" ø pipes.

PLAN - VIEW

(Show a minimum of three reference ties to durable physical objects, relevant monuments and physical conditions that will enable recovery of the corner.)

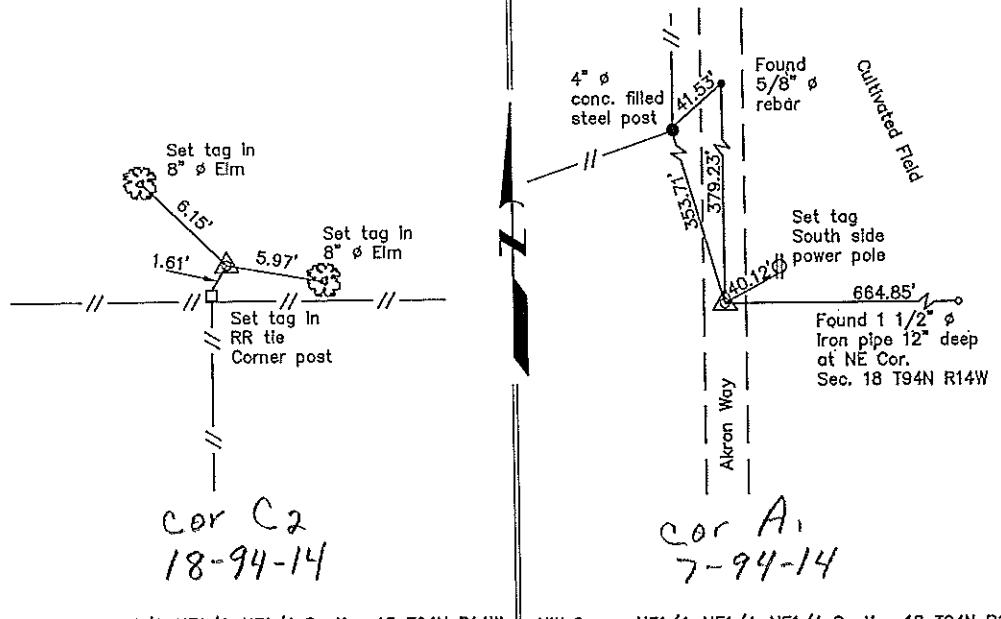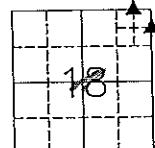

SE Corner NE1/4-NE1/4-NE1/4 Section 18 T94N R14W

NW Corner NE1/4-NE1/4-NE1/4 Section 18 T94N R14W

I hereby certify that this land surveying document was prepared and the related survey work was performed by me or under my direct personal supervision and that I am a duly licensed Land Surveyor under the laws of the State of Iowa.

A circular stamp with a double-lined border. The outer border contains the words "PROF. ENGR. & LAND SURVEYOR" in a dotted pattern. The inner circle contains the text "LYLE G. TEKIPPE" on top and "7060" on the bottom, with "IOWA" at the bottom. There are two five-pointed stars, one on each side of the "IOWA" text.

Lyle G. Tekkie 3-6-91
Lyle G. Tekkie Date
License number 7080
My license renewal date is December 31, 1998.
Sheets covered by this seal: Individual

List Corners to be Indexed

Corners	Section	Twp.	Range
SE-NE-NE-NE	18	94N	C ₂ 14W
NW-NE-NE-NE	18	94N	14W

Con. A. 7-94-14

Placed in the book 3/25/91.

UNITED STATES PUBLIC LAND SURVEY CORNER CERTIFICATE
OF

Land Survey Monuments situated in Section 7, Township 94 North, Range 14 West, of the Fifth Principal Meridian, CHICKASAW County, Iowa. Previously recorded in NONE (book, page, document number, etc.)

(Show reason for preparing this certificate, the evidence and detailed procedures used in establishing the corner positions and monumentation found or placed.)



Monument Description and Remarks: SW CORNER, SECTION 7-T94N-R14W:

Found 60^d Nail.

SE CORNER, SECTION 7-T94N-R14W: Found 1" Gas Pipe.

PLAN - VIEW

(Show a minimum of three reference ties to durable physical objects, relevant monuments and physical conditions that will enable recovery of the corner.)

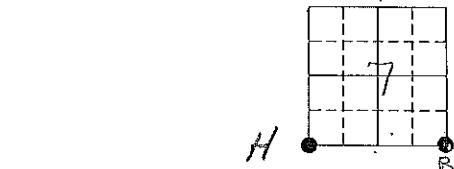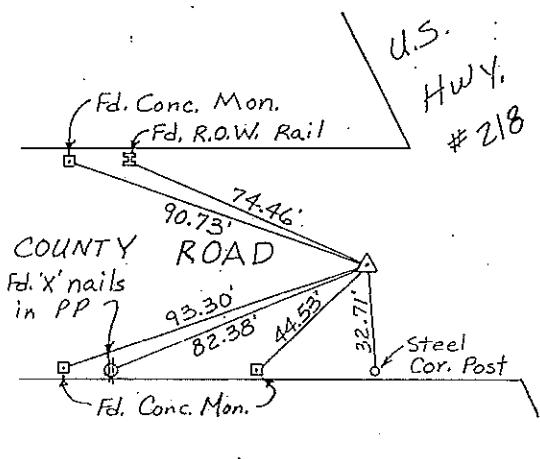


SW CORNER, SECTION 7-T94N-R14W

I hereby certify that the survey work was completed and this certificate was prepared by me or under my direct personal supervision and that I am a duly registered land surveyor under the laws of the state of Iowa.

Signature: Lyle G. TeKippe
Lyle G. TeKippe

Date: 6-20-95 Reg. No. 7060
My Registration Renewal Date is December 31, 1996

Seal

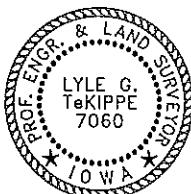

SE CORNER, SECTION 7-T94N-R14W

List Corners to be Indexed			
Corners	Section	Twp.	Range
SW Cor H	7-T94N	94N	14W
SE	7	94N	14W
Cor B	7	94-14	

placed in tri
Box 6/23/95