

*Chickasaw* COUNTY  
LAND SURVEY MONUMENT RECORD


E1  
Sec 19 T 94 N R 14 W

All items to be completed. Please print or type.

1. Type of Monument  
(check one)

- Section Corner       Bench Mark
- Quarter Corner       Other NW cor NE NW

2. Description of Evidence found and location. NW cor NE 1/4 NW 1/4  
*Relocated on line between N 1/4 cor and NW cor Sec 19 at dist shown on M.E. Hicketier Survey of lots along South side SE 1/4 SW 1/4 of Section 18-94-14.*

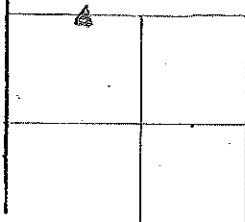


3. Description of monument and/or accessories established by you to perpetuate the location of this point.

*Set conc. nail in asphalt as shown in sketch at right.*

D. BUSS  
J. DEENY  
D. ANDERSON

4. Sketch showing relative location of monument and reference points. Show supporting and/or contradictory evidence where applicable.

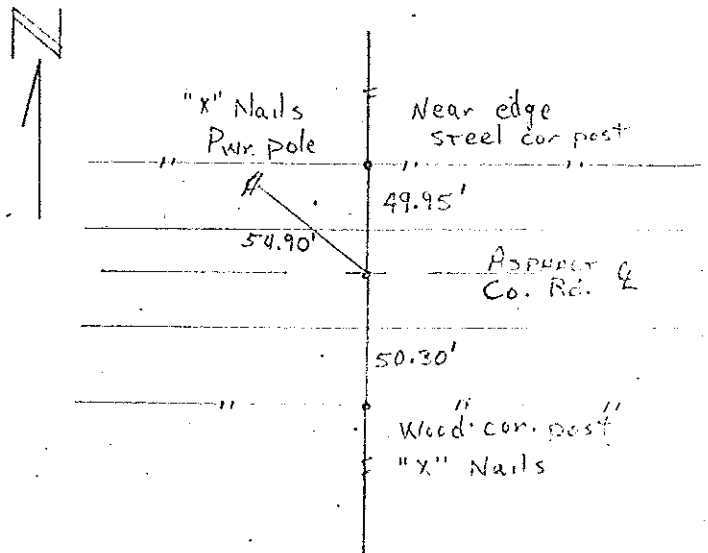

Date of Field Work 8/29/75

Signed David Russ  
WHKS & Co.