

FILED 2004-0884

RECORDER'S OFFICE
CHICKASAW COUNTY, IOWA

2004 APR 19 ^{11:00} AM 9 23

CINDY MESSERSMITH
COUNTY RECORDER

Section 31-94-14
As ref. to in
Engr. Tie Book

STEVE BUSSE P.O. BOX 241 508 ELM STREET ALLISON, IOWA 50602 (319) 267-2519

UNITED STATES PUBLIC LAND SURVEY CORNER CERTIFICATE

Land Survey Monuments situated in Section: 1 31 Township: 93 North
Range: 1415 West Of the Fifth Principal Meridian, Butler County, Iowa.
Previously recorded in N/A In County Recorder's Office.

(Show reason for preparing this certificate, the evidence and detailed procedures used in establishing the corner positions and monumentation found or placed.)

Monument Description and Remarks: Found 1" iron pin in center of intersection. Ties from Floyd County Engineer calls for iron pin over limestone.

PLAN - VIEW

(Show a minimum of three reference ties to durable physical objects, relevant monuments and physical conditions that will enable recovery of the corner.)

56.00' NW to conc. monu.

47.00' NW to gas pipe

Floyd Line St.

54.55' SW to conc. monu.




Butler Ave.

45.10' NE to conc. monu.

NE COR 1-93-15

Cor H

31-94-14

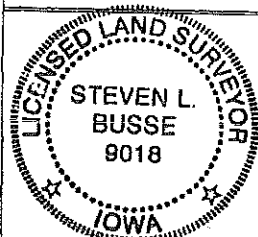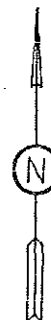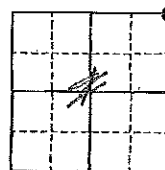

I hereby certify that this land surveying document was prepared and the related survey work was performed by me or under my direct personal supervision and that I am a duly Licensed Land Surveyor under the laws of the State of Iowa.

Steve Busse 4/10/04
STEVE BUSSE DATE

License number 9018

My license renewal date is Dec 31, 2004

Pages or sheets covered by this seal: 1

List Corners to be indexed

Corners	Section	Twp.	Range
NE	1	93	15
SE	36	94	15
NW	6	93	14
SW	31	94	14

6-24-76


SCALE FOR SECTION, } Each side large blue squares = 20 chains, 80 rods, 1320 feet; area of square 40 acres.
660 Ft. = 1 Inch. } Each side small red squares = 5 chains, 20 rods, 330 feet; area of square 2 1/2 acres.

92° N 15

Notes &

G.P. = Gas Pipe

C.M. = Concrete Monument

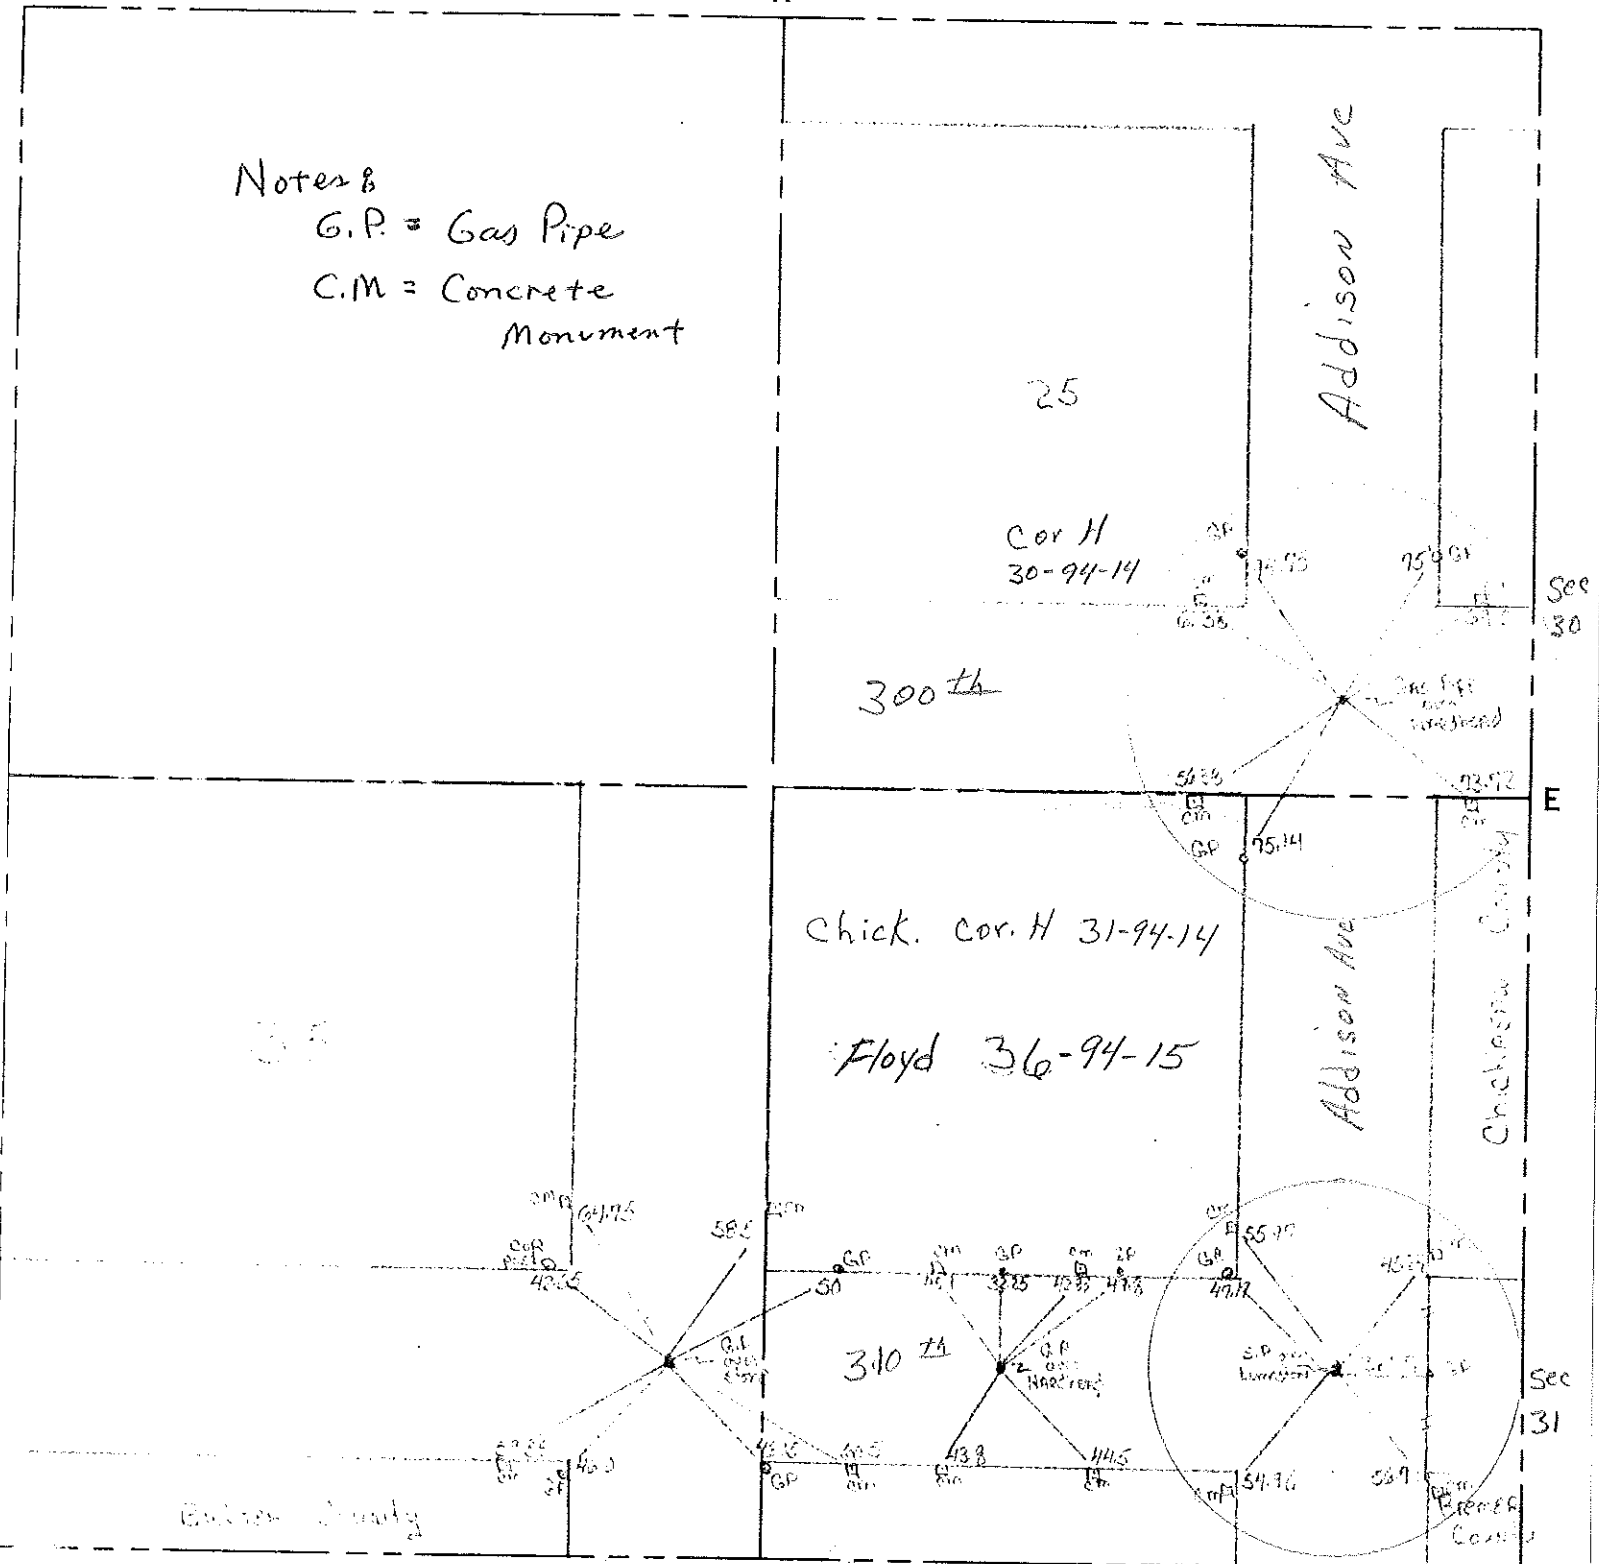

SCALE FOR QUARTER SECTION, } Each side large blue squares = 10 chains, 40 rods, 660 feet; area of square 10 acres.
330 Ft. = 1 Inch. } Each side small red squares = 2 1/2 chains, 10 rods, 165 feet; area of square .625 of 1 acre.

PRONTO LAND MEASURE 660-330 MAP SHEET

PRONTO LAND MEASURE
Copyright, 1950, James Hamilton Adair, Flint, Michigan