Section 35-94-14 As ref. to in Engli Til Book

2007-1103.

STEVE BUSSE

- P.O. BOX 241

508 ELM STREET

ALLISON, IOWA 50602

(319) 267-2519

UNITED STATES PUBLIC LAND SURVEY CORNER CERTIFICATE


Land Survey Monuments situated in Section: 4 Township: 93 North

Range: 14 West Of the Fifth Principal Meridian, Bremer County, Iowa.

Previously recorded in N/A In County Recorder's Office.

Monument Description and Remarks: FOUND 1" AXLE ROD IN CENTER OF INTERSECTION AT NW CORNE SECTION FROM INFORMATION FROM CHICKASAW COUNTY ENGINEERS OFFICE. FOUND 1/2" REBAR AT NORTH 1/4 CORNER. CORNER IS IN LINE WITH FENCE TO NORTH. FOUND FROM INFORMATION FROM CHICKASAW COUNTY ENGINEERS OFFICE. USED CORNERS IN SURVEY IN SECTION 1.

PLAN - VIEW

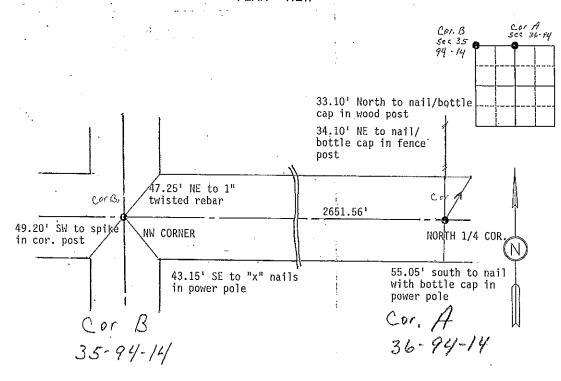



I hereby certify that this land surveying document was prepared and the related survey work was performed by me or under my direct personal supervision and that I am a duly licensed Land, Surveyor under the laws of the State, of laws.

STEVE BUSSE

5/28/07 DATE

Ucense number 9018

My license renewal date is Dec 31, 2008

Pages or sheets covered by this seal:

List Corners		to be	indexed:	
Corners	Sect.	Тwp	Range	
NW cor.	1	93	14	
North 1/4	1	93	14	
SW cor.	36	94	14	
South 1/4	36	94	14	

Section 35-94-14
As ref. to in
Engr. The Book

SLSI 9-94

UNITED STATES PUBLIC LAND SURVEY CORNER CERTIFICATE

OF 3		
Land Survey Monuments situated in Section 36	Township 94 hrchasaw in County R	, Range
11cviousiy recorded in		
(Show reason for preparing this certificate, the evidence and detailed proc mentation found or placed.) Monument Description and Remarks:	dures used in establishing the comer p	ositions and monu-
	<u> </u>	
PLAN - VIE	W	
(Show a minimum of three reference ties to durable physical objects, rele recovery of the corner.) (Show a minimum of three reference ties to durable physical objects, rele recovery of the corner.) (Show a minimum of three reference ties to durable physical objects, rele recovery of the corner.)	ant monuments and physical condition	ns that will enable
in powerpole Wy Go 15-95-10 15-95	7-14	
Corc		A
35-94-14		
4 C C C C C C C C C C C C C C C C C C C	5/4 Con Sec. 36-94-14 (Found "2" re-bar On fenceline horth)	1 60 the grant of
# 1" twick! ta-bat		2
S.M Goh Sec 36-94.14 E County	Road	13 34.9° II
S.M. Con See 36-94-14 Found 1"aile) 90 16.85 35-94-14	51.74'	36-94-14
Spike in "X hall in		53
Cor. Post		Nailtbottle car in power pole
I hereby certify that the survey work was completed and this land surveying document was prepared by me or under my direct personal supervision and that I am a duly registered land surveyor under the laws of the state of lowa	SW 36-9	Twp Range
Signature: Harlan K Schuck Name typed or printed: Harlan K Schuck Date: 9/13/96 Reg. No. 9962	W.1/x 36 - 9	C-35-74
My registration renewal date is December 31, 1997		, - I .
	P Dell	1 in 300 1/9/4
. SEAL		Door 1/94
	1,0	101134