

Chickasaw Co. Recorder  
Cindy Messersmith

**Fee Book 2009-0938**

05/07/2009 @0953AM  
SCC SEC COR CERT

Book: Page: # Pages: 1  
Total Fees: \$7.00

*Herold - Reicks Surveying, 25 1/2 East Main Street, Suite 204, New Hampton, IA 50659, Ph. 641-394-2725*

## UNITED STATES PUBLIC LAND SURVEY CORNER CERTIFICATE

Land Survey Monuments situated in Section **5**, Township **94** North, Range **14** West of the Fifth Principal Meridian, **Chickasaw** County, Iowa. Not previously recorded in the County Recorder's office.

This certificate is being prepared in compliance with Iowa Code Chapter 355.11 because:


- There is no certificate on file for this corner.
- There are no longer three valid ties of record.
- There are changes to reference ties of record.
- There is change of monumentation of record.
- To clarify description of record monument (ties).

Monument Description and Remarks:

- 1.) Center of Section:** Set 5/8"Ø rebar with 2"Ø aluminum cap PLS 19211 at the intersection of 1/4 Section Lines.
- 2.) NW Corner of the NE 1/4-SW 1/4:** Set 5/8"Ø rebar with 2"Ø aluminum cap PLS 19211 equidistant and online between the Center of Section and the West 1/4 Corner.

### PLAN - VIEW

(Show a minimum of three reference ties to durable physical objects, relevant monuments and physical conditions that will enable recovery of the corner.)

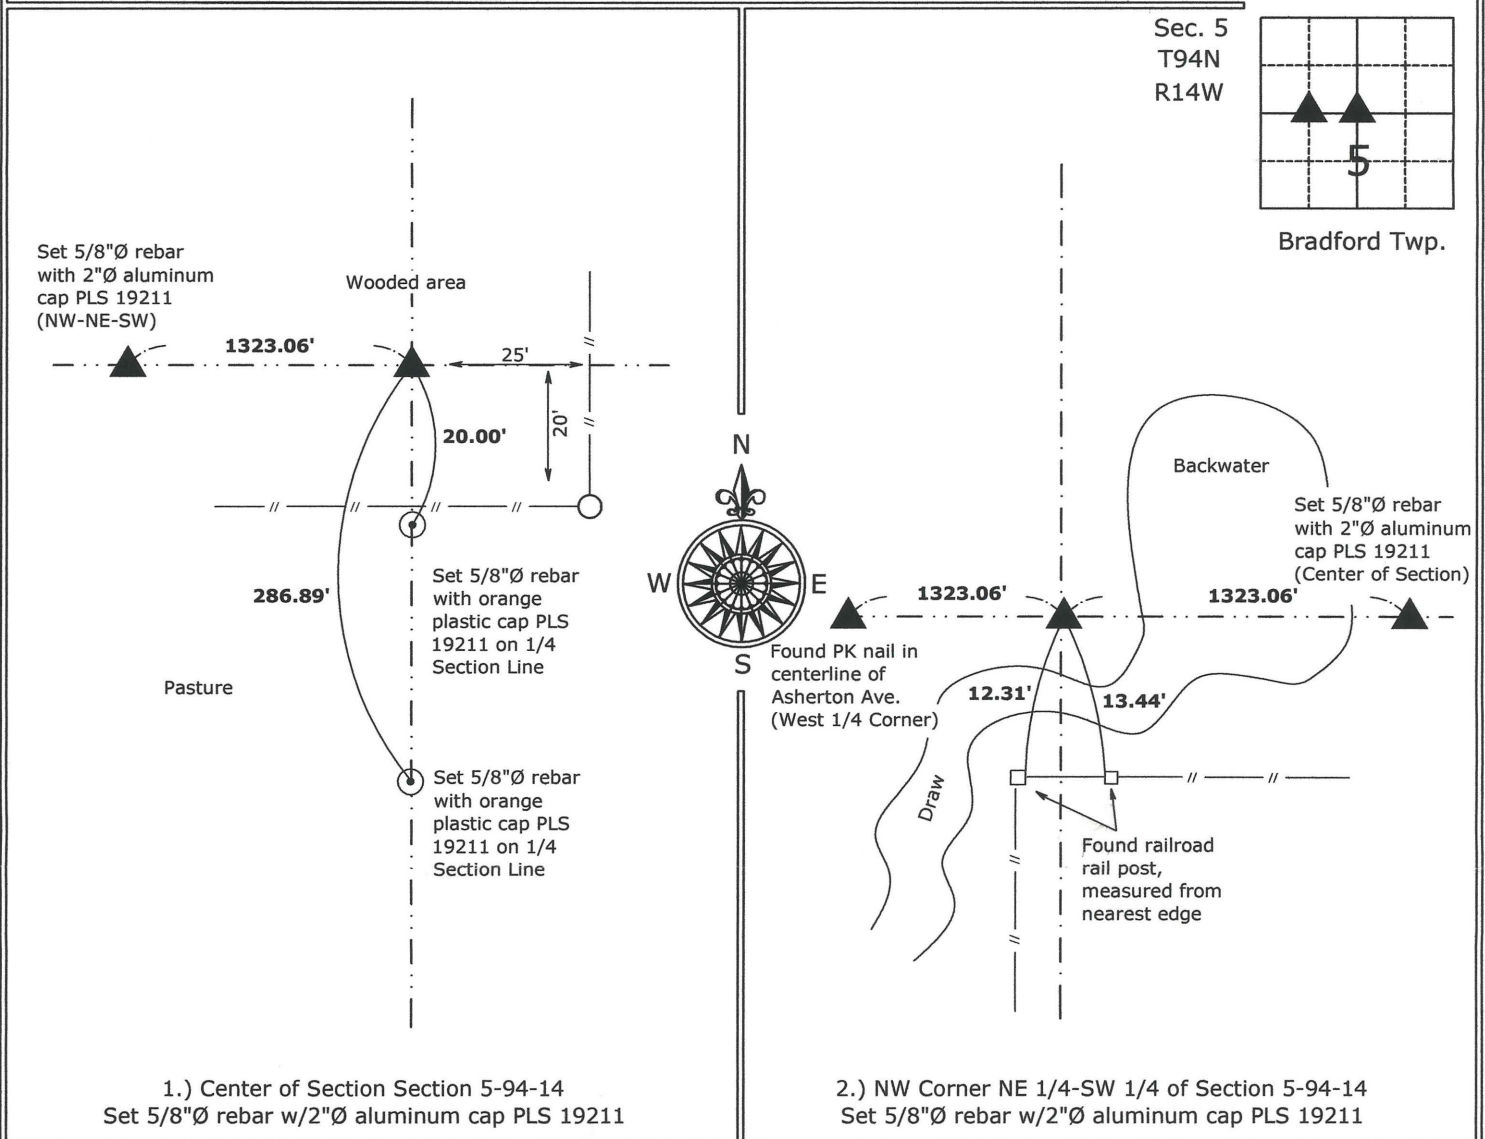

1.) Center of Section Section 5-94-14  
Set 5/8"Ø rebar w/2"Ø aluminum cap PLS 19211

2.) NW Corner NE 1/4-SW 1/4 of Section 5-94-14  
Set 5/8"Ø rebar w/2"Ø aluminum cap PLS 19211



I hereby certify that this land surveying document was prepared and the related survey work was performed by me or under my direct personal supervision and that I am a duly licensed Land Surveyor under the laws of the State of Iowa.

*Kirk D. Reicks* 5-2-09  
Kirk D. Reicks Date:

License number 19211  
My license renewal date is December 31, 2010.  
Sheets covered by this seal: Individual sheet only

List Corners to be Indexed			
Corners	Section	Twp.	Range
Center	5	94	14
NW-NE-SW	5	94	14

Project Number: 2009-040

FB: Chickasaw County 3, Pgs. 31-32

File: