

Chickasaw Co. Recorder
Cindy Messersmith
Fee Book 2012-1332
07/05/2012 @0257PM
SCC SEC COR CERT
Book: Page: # Pages: 1
Total Fees: \$7.00

Prepared by & Return to: Harold - Reeks Surveying, 19 East Main Street, New Hampton, IA 50659, Ph. 641-384-2725

UNITED STATES PUBLIC LAND SURVEY CORNER CERTIFICATE

Land Survey Monuments situated in Section 6, Township 94 North, Range 14 West of the Fifth Principal Meridian, Chickasaw County, Iowa. 1.) Previously recorded in Bk. 2011, Pg. 1113 in the County Recorder's office. 2.) Previously recorded in Bk. 2007, Pg. 0649 in the County Recorder's office.

This certificate is being prepared in compliance
with Iowa Code Chapter 355.11 because:

182 There is no certificate on file for this corner.
 There are no longer three valid ties of record.
 There are changes to reference ties of record.
 There is change of monumentation of record.
 To clarify description of record monument (ties).


Monument Description and Remarks:

1.) Northeast Corner: Set 1"Ø Bronze Survey Marker PLS 19211 at previous location (Found MAG Nail) by means of coordinates obtained prior to highway reconstruction, Project No. STP-S-CO19(80)--5E-19.

2.) **East 1/4 Corner:** Set 1"Ø Bronze Survey Marker PLS 19211 at previous location (Found MAG Nail) by means of coordinates obtained prior to highway reconstruction, Project No. STP-S-CO19(80)--5E-19.

PLAN - VIEW

(Show a minimum of three reference ties to durable physical objects, relevant monuments and physical conditions that will enable recovery of the corner.)

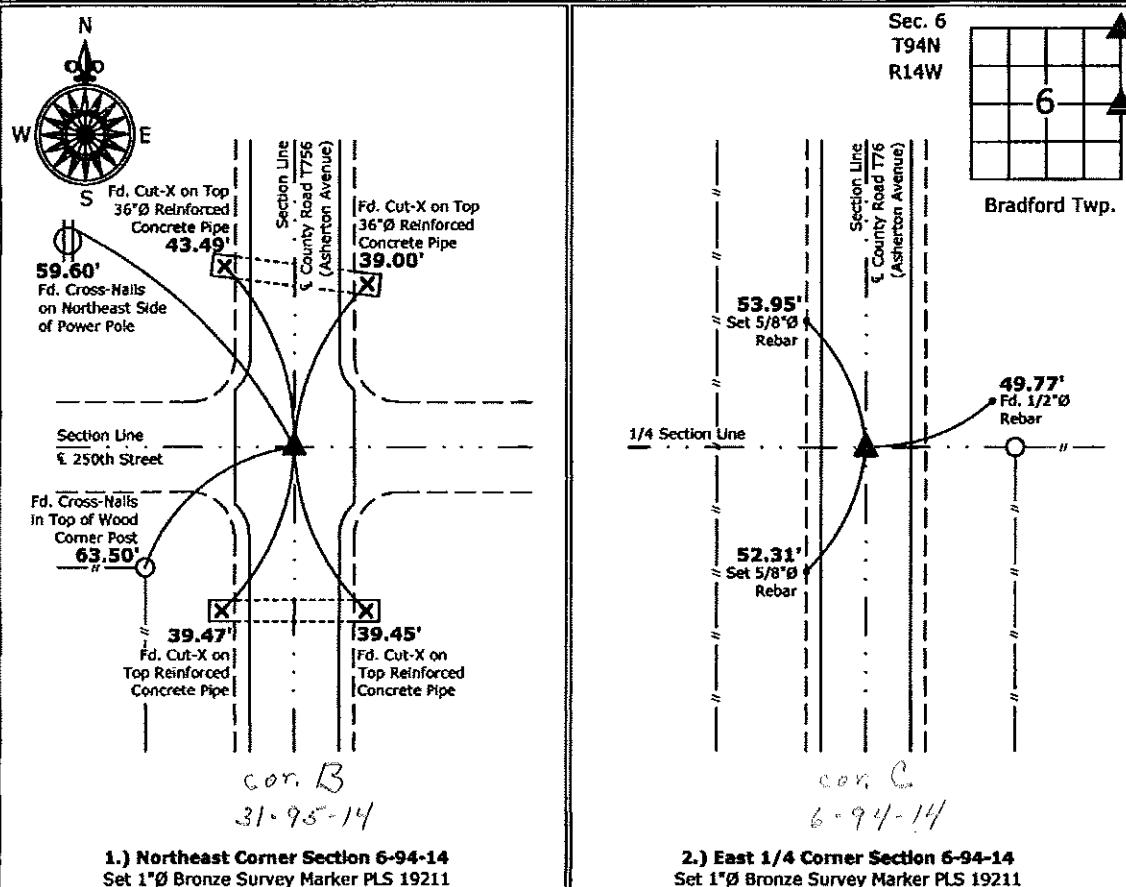

**1.) Northeast Corner Section 6-94-14
Set 1"Ø Bronze Survey Marker PLS 19211**

2.) East 1/4 Corner Section 6-94-14
Set 1"Ø Bronze Survey Marker PLS 19211



I hereby certify that this land surveying document was prepared and the related survey work was performed by me or under my direct personal supervision and that I am a duly licensed Land Surveyor under the laws of the State of Iowa.

Kirk D. Reicks 7-5-12
Kirk D. Reicks Date:

License number 19211

List Corners to be Indexed			
Corners	Section	Twp.	Range
NE	6	94	14
E 1/4	6	94	14