

2006-0845

Scott A. Steinfadt LS, Ryken Engineering, 403 N. Monroe, P.O. Box 1352, Mason City, Ia. 50401 - Ph 641-423-1451

UNITED STATES PUBLIC LAND SURVEY CORNER CERTIFICATE OF

Land Survey Monuments situated in Section 5, Township 94 North, Range 14 West, of the Fifth Principal Meridian, Chickasaw County, Iowa, Previously recorded in Not Applicable in County Recorder's Office

(Show reason for preparing this certificate, the evidence and detailed procedures used in establishing the corner positions and monumentation found or set.)

Monument Description and Remarks:

SE Cor. - History of Corner = Current Co Engr's records indicated that corner is monumented with 'iron pin' on '5-27-54' with ties as shown below.


Corner Recovery: Searched area with metal detector, excavated a 1' x 1' x 0.6' deep hole, and found Yellow painted Iron T-bar 0.3' deep. Probed on all sides of T-bar and hit a stone at 1.4' deep in centerline of gravel roads N-S & W. Monuments found are only ones available and match existing road evidence well. Therefore, used cross of 'T' as the correct corner. All ties are plumb distance unless indicated otherwise.

This certificate is being prepared because there are no certificates on file for this corner and this corner was used for a survey in this section for Daniel D. and Maria E. Janssen.

Plan View

(Show a minimum of three reference ties to durable physical objects, relevant monuments, and physical conditions that will enable recovery of the corner.)

SE Cor.


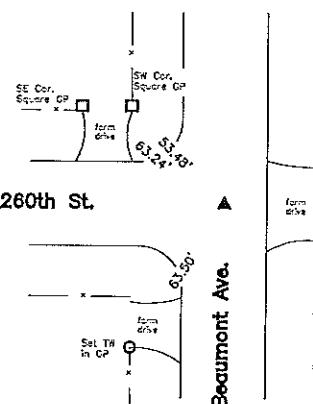


Cor B

Legend

BC = Nail w/ Bottle Cap
 BP = Brace Post
 CP = Corner Post
 CM = 4" Sq Concrete Monument w/
 1/2" Iron recd in center
 (tie to recd)
 CX = Cut 'X'
 GP = Gole Post
 GFW = Nail w/ Green Plastic Washer
 PW = Plain 'X'
 RH = Red Head (Nail in wire)
 SFP = Steel Fence Post
 RW = Nail w/ Reflective Round Washer
 R/W = Iron ROW Rail
 SM = Nail w/ Yellow Plastic Survey Marker
 SW = Nail w/ Square Metal Washer
 TP = Telephone Pedestal
 TW = Nail w/ Round Metal Washer
 WFP = Wood Fence Post
 X = X Nails

CO ENGR'S RECORD TIES

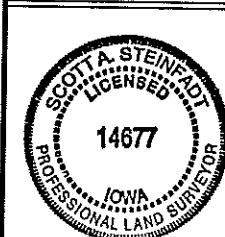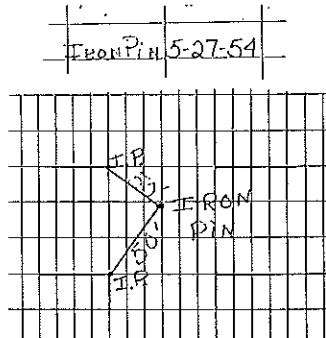

I hereby certify that this land surveying document was prepared and the related survey work was performed by me or under my direct personal supervision and that I am a duly licensed land Surveyor under the laws of the State of Iowa.

Scott A. Steinfadt
 SCOTT A. STEINFADT, LS
 Date: 4-14-06 License number: 14677
 My license renewal date is December 31, 2006

Pages or sheets covered by this seal: 1

List Corners to be Indexed

Corners	Section	Twp	Range
SE Cor.	5	T94N	R14W