

Herold - Recks Surveying, 10 East Main Street, New Hampton, IA 50659, Ph. 641-394-2725, Fax. 641-394-2718

UNITED STATES PUBLIC LAND SURVEY CORNER CERTIFICATE

Land Survey Monuments situated in Section 9, Township 94 North, Range 14 West of the Fifth Principal Meridian, Chickasaw County, Iowa. 1.) Not previously recorded in the County Recorder's office. 2.) Previously recorded Doc. #2002-0749 in the County Recorder's office.

This certificate is being prepared in compliance with Iowa Code Chapter 355.11 because:



- 1.) There is no certificate on file for this corner.
- There are no longer three valid ties of record.
- There are changes to reference ties of record.
- 2.) There is change of monumentation of record.
- To clarify description of record monument (ties).

Monument Description and Remarks:

- 1.) **Center of Section:** Found 5/8"Ø Rebar with information obtained at the County Engineer's office.
- 2.) **South 1/4 Corner:** Found Survey Mark Nail with I.D.O.T. stainless steel washer matching the reference ties on the previous Section Corner Certificate, the previous monument was covered by an HMA Overlay project and the Corner was remonumented by the Iowa D.O.T.

PLAN - VIEW

(Show a minimum of three reference ties to durable physical objects, relevant monuments and physical conditions that will enable recovery of the corner.)

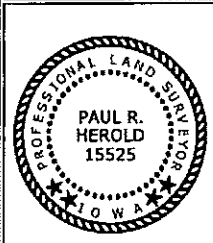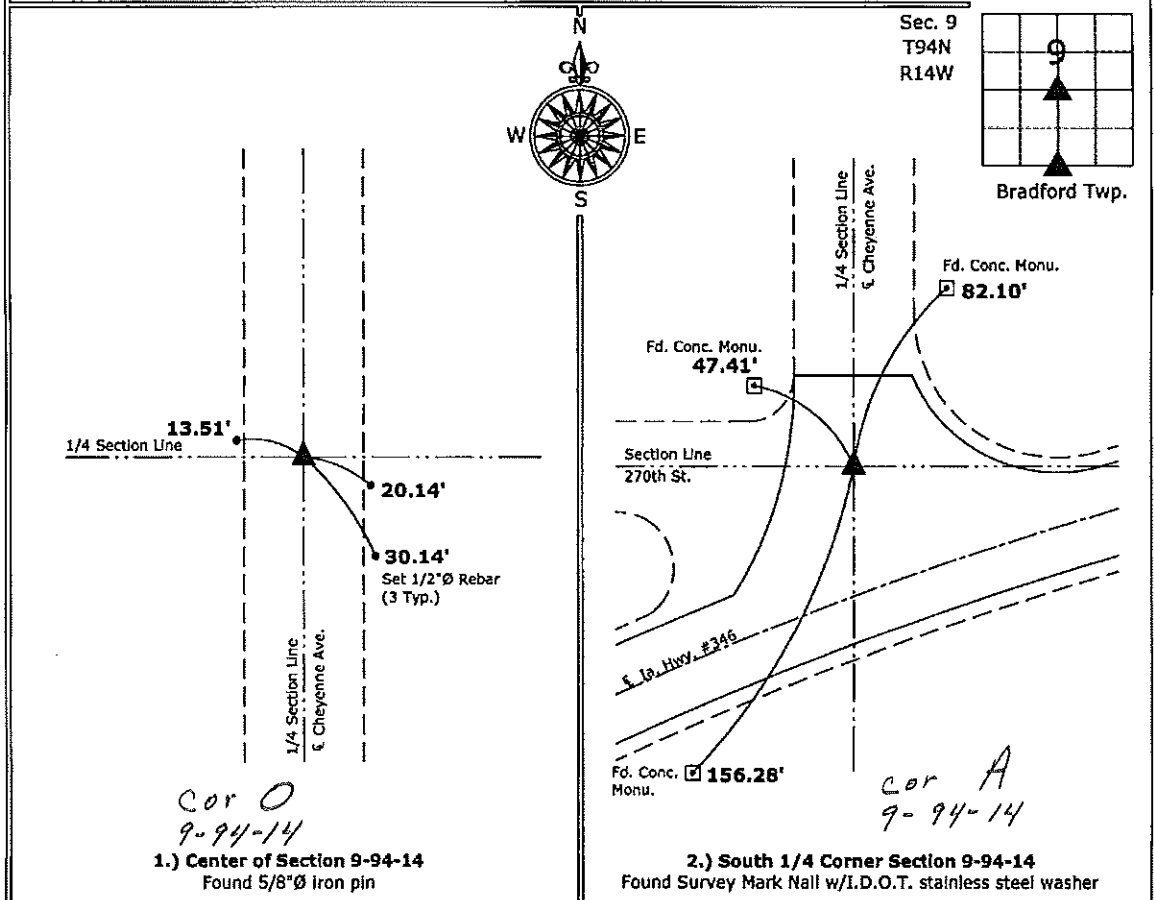

I hereby certify that this land surveying document was prepared and the related survey work was performed by me or under my direct personal supervision and that I am a duly licensed Land Surveyor under the laws of the State of Iowa.

Paul R. Herold 12-27-10
 Date: Paul R. Herold

License number 15525
 My license renewal date is December 31, 2010.
 Sheets covered by this seal: Individual sheet only

List Corners to be Indexed			
Corners	Section	Twp.	Range
CTR	9	94	14
S 1/4	9	94	14

Project Number: 2010-153
 FB: Chickasaw County 3, Pg. 60

File: S:_Projects\2010-153\dwg\2010-153.dwg, 12/27/2010 01:26:31