

Section 4-94-14
 As referred to in
 Engr. Tie Book

FILED 2005 -1472
 RECORDER'S OFFICE
 CHICKASAW COUNTY, IOWA
 2005 JUL 19 AM 8 35
 GINDY HESSERSMITH
 COUNTY RECORDER

PREPARED BY/RETURN TO: KENNETH D. STARK STARK SURVEYING 1822 So. Tall Ave. MASON CITY, IOWA 50401 841-423-7947

UNITED STATES PUBLIC LAND SURVEY CORNER CERTIFICATE OF


Land Survey Monuments situated in Section 9 4, Township 94N, Range 14W
 of the Fifth Principal Meridian, CHICKASAW County, Iowa.

Previously recorded in NA in County Recorder's Office.
(book, page, document number, etc.)

(Show reason for preparing this certificate, the evidence and detailed procedures used in establishing the corner positions and monumentation found or placed.)

Monument Description and Remarks: _____

N¹/₄ COR = FOUND IRON PIN PER COUNTY TIES

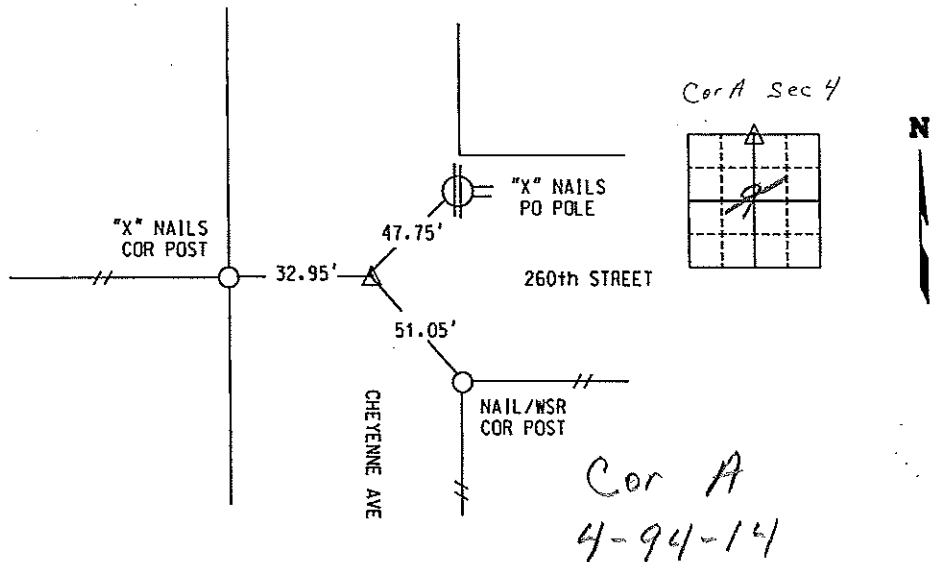

Cor A
 4-94-14

LICENSED LAND SURVEYOR
 KENNETH D. STARK
 10898
 IOWA

I hereby certify that this land surveying document was prepared and the related survey work was performed by me or under my personal supervision and that I am a duly licensed Land Surveyor under the laws of the state of Iowa.
 Kenneth D. Stark Date 07-12-05
 License number 10898
 My License renewal date is December 31, 2005
 Pages or sheets covered by this seal. 1

List Corners to be Indexed			
Corner	Section	Township	Range
N ¹ / ₄	9	94	14