

Instrument #: 2024-0639  
 05/08/2024 11:32:55 AM Total Pages: 1  
 SCC SECTION CORNER CERTIFICATES  
 Recording Fee: \$ 7.00  
 Shirley Troyna, Recorder, Chickasaw County Iowa



Prepared by & Return to: Kirk D. Reicks, HRS, LLC, 10 East Main Street, New Hampton, IA 50659, Phone 641-994-2725

### United States Public Land Survey Corner Certificate

Land Survey Monument situated in  
 Section 21, Township 95 North, Range 14 West of the Fifth Principal Meridian, Chickasaw County, Iowa.  
 Not on file in the County Recorder's Office.

This certificate is being prepared in compliance with Iowa Code Chapter 355.11 because:
 

- There is no certificate on file for this corner.
- There are no longer three valid ties of record.
- There are changes to reference ties of record.
- There is change of monumentation of record.
- To clarify description of record monument (ties).


**Monument Description and Remarks:**

**Southeast Corner of the SW 1/4 - NW 1/4:**

Found 5/8"Ø Rebar w/2"Ø Aluminum Cap PLS 15525 with information obtained from a Survey and Plat, as recorded in Document #2013-1509 on file in the County Recorder's Office.

### Plan View - Not to Scale


(Show a minimum of three reference ties to durable physical objects, relevant monuments and physical conditions that will enable recovery of the corner.)

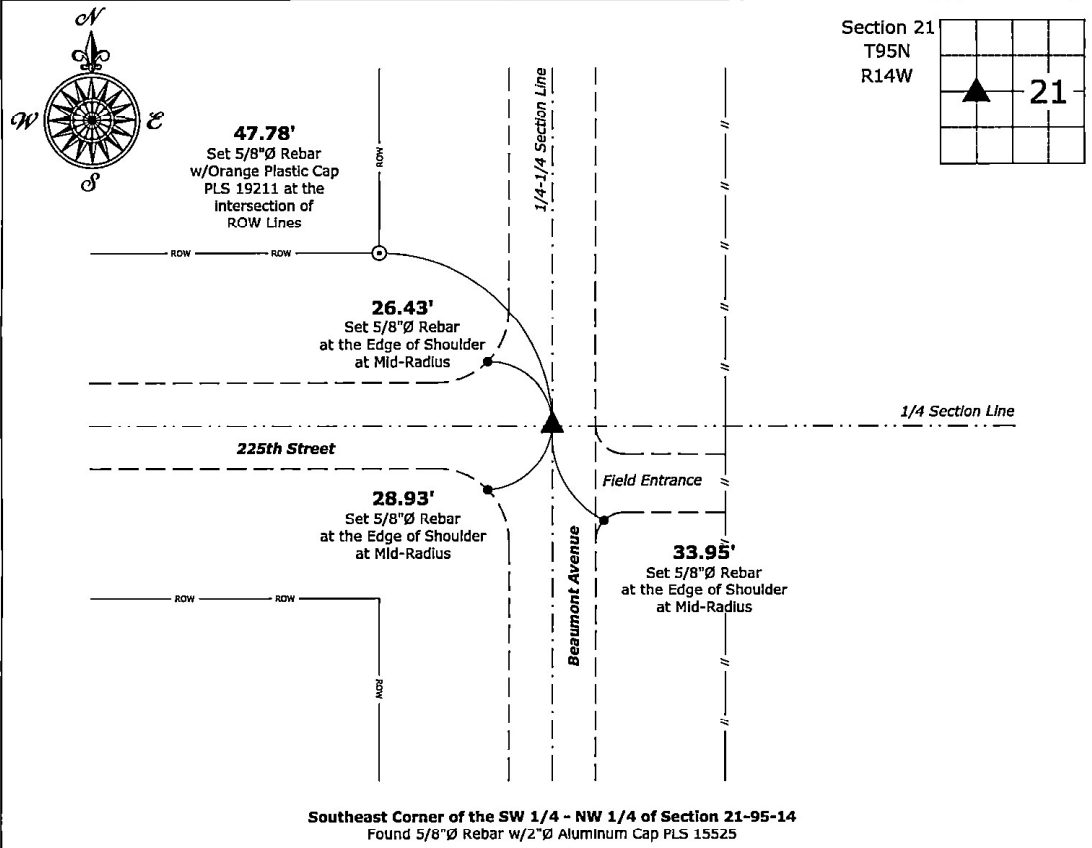

COR P  
 21-95-14

File: S:\\_Projects - NHO\Chickasaw\CHICK-32 - 2024.dwg, 5/7/2024 11:26:57 AM

**Southeast Corner of the SW 1/4 - NW 1/4 of Section 21-95-14**  
 Found 5/8"Ø Rebar w/2"Ø Aluminum Cap PLS 15525

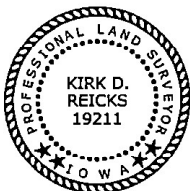

I hereby certify that this land surveying document was prepared and the related survey work was performed by me or under my direct personal supervision and that I am a duly licensed Land Surveyor under the laws of the State of Iowa.

*Kirk D. Reicks* 5-7-2024  
 Kirk D. Reicks Date:

License number 19211  
 My license renewal date is December 31, 2024.  
 Sheets covered by this seal: Individual sheet only

List Corner to be Indexed

Corner	Section	Township	Range
SE-SW-NW	21	95	14

Project Number: 2024-047

FB: Chickasaw 12, Page(s) 57-58