

UNITED STATES PUBLIC LAND SURVEY CORNER CERTIFICATE

OF

Land Survey Monuments situated in Section 23, Township 95 North, Range 14 West of the Fifth Principal Meridian, CHICKASAW County, Iowa. Previously recorded in none in County Recorder's Office. (book, page, document number, etc.)

(Show reason for preparing this certificate, the evidence and detailed procedures used in establishing the corner positions and monumentation found or placed.)


Monument Description and Remarks: **W 1/4 Corner Section 23 T95N R14W:** Found bent 1/2" square iron bar, 2' deep, on the extension of a quarter section line fence to the centerline of Durham Ave. Replaced iron bar with 1/2"Ø rebar w/2"Ø aluminum cap LS 7060.

S 1/4 Corner Section 23 T95N R14W: Found 1/2"Ø rebar with information obtained from the Chickasaw County Engineer's Office in the Field Book for Chickasaw Twp. Corner Ties, Corner 'A', Section 23.

PLAN - VIEW


Project Number 00126.18
FR 45G PG. 70-74

(Show a minimum of three reference ties to durable physical objects, relevant monuments and physical conditions that will enable recovery of the corner.)

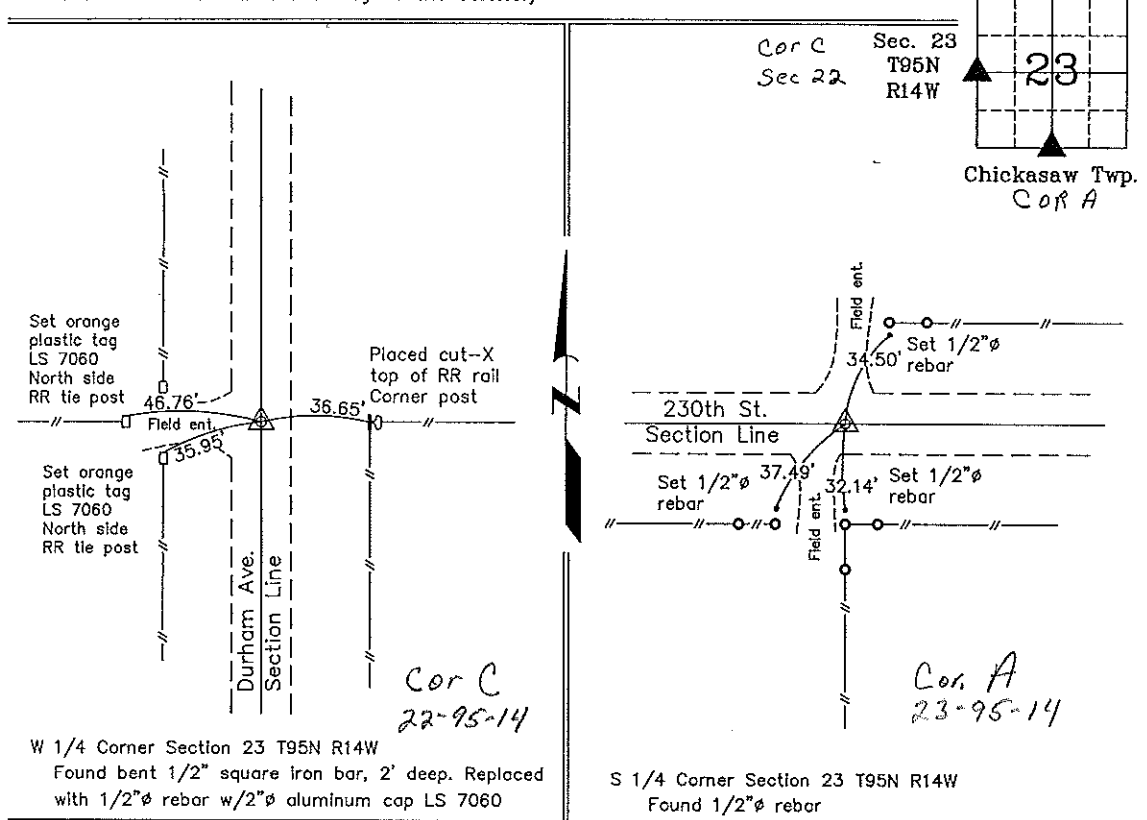

W 1/4 Corner Section 23 T95N R14W
Found bent 1/2" square iron bar, 2' deep. Replaced with 1/2"Ø rebar w/2"Ø aluminum cap LS 7060

S 1/4 Corner Section 23 T95N R14W
Found 1/2"Ø rebar

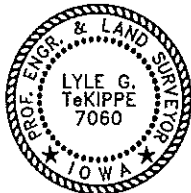

I hereby certify that this land surveying document was prepared and the related survey work was performed by me or under my direct personal supervision and that I am a duly licensed Land Surveyor under the laws of the State of Iowa.

Lyle G. TeKippe 7-25-00
Lyle G. TeKippe Date

License number 7060
My license renewal date is December 31, 2000.
Sheets covered by this seal: Individual

List Corners to be Indexed			
Corners	Section	Twp.	Range
W 1/4	23	95N	14W
S 1/4	23	95N	14W

Filed 7-27-00