

PREPARED BY KENNETH D. STARK 1622 SOUTH TAFT AVENUE, MASON CITY, IOWA 50401 (641) 423-7947

UNITED STATES PUBLIC LAND SURVEY CORNER CERTIFICATE

OF
LAND SURVEY MONUMENTS SITUATED IN SECTION 22, TOWNSHIP 95N, RANGE 14W, OF THE 5th PRINCIPAL MERIDIAN
CHICKASAW COUNTY, IOWA PREVIOUSLY RECORDED IN (NOT APPLICABLE) IN COUNTY RECORDER'S OFFICE.


MONUMENT DESCRIPTION AND REMARKS:

S 1/4 COR - SET 1/2" REBAR W/YELLOW PLASTIC CAP 10898 2" DEEP OVER


FOUND 5/8" IRON PIN 22" DEEP PER COUNTY RECORD

REASON FOR CERT: NO CERT OF RECORD & PERPETUATED MONUMENTATION

PLAN VIEW

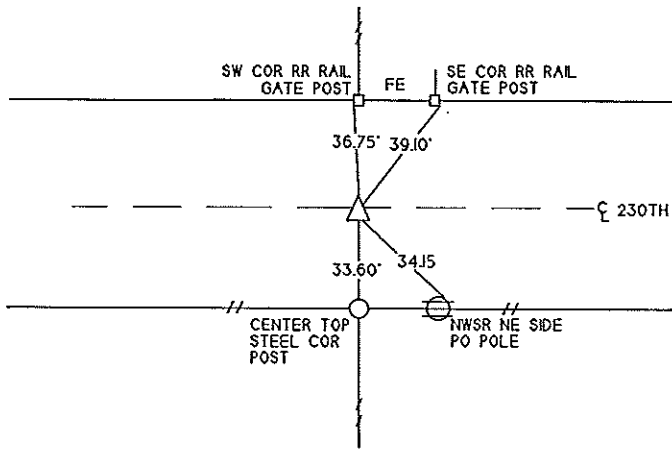

COR. A
22-95-14

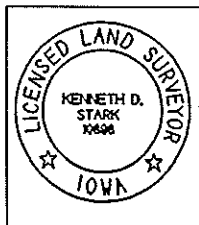

I HEREBY HEREBY CERTIFY THAT THIS LAND SURVEYING DOCUMENT WAS PREPARED AND THE RELATED SURVEY WAS PERFORMED BY ME OR UNDER MY PERSONAL SUPERVISION AND THAT I AM A DULY LICENSED LAND SURVEYOR.
Kenneth D. Stark 01-20-09
KENNETH D. STARK DATE
LICENSE NUMBER 03898
MY LICENSE RENEWAL DATE IS DECEMBER 31, 2009
PAGES OR SHEETS COVERED BY THIS SEAL 1

CORNERS	SECTION	TWP	RANGE
S 1/4 COR	22	95	14
