

Instrument #: 2021-1461
 08/29/2021 11:59:30 AM Total Pages: 1
 SCC SECTION CORNER CERTIFICATES
 Recording Fee: \$ 7.00
 Shirley Troyna, Recorder, Chickasaw County Iowa



Prepared by & Return to: Herold - Reicks Surveying, 10 East Main Street, New Hampton, IA 50659, Ph. 641-394-2725

United States Public Land Survey Corner Certificate

Land Survey Monument situated in
 Section 30, Township 95 North, Range 14 West of the Fifth Principal Meridian, Chickasaw County, Iowa.
 Not on file in the County Recorder's office.

This certificate is being prepared in compliance with Iowa Code Chapter 355.11 because:




- There is no certificate on file for this corner.
- There are no longer three valid ties of record.
- There are changes to reference ties of record.
- There is change of monumentation of record.
- To clarify description of record monument (ties).

Monument Description and Remarks:

Southeast Corner of the NE 1/4 - NE 1/4: Calculated Corner equidistant and on line between the Northeast and East Quarter Corners of said Section. Corner lands on a large rock, therefore set 5/8"Ø Rebar w/2"Ø Aluminum Cap PLS 19211, on Section Line, 2.00' North as a Witness Corner.

Plan View

(Show a minimum of three reference ties to durable physical objects, relevant monuments and physical conditions that will enable recovery of the corner.)

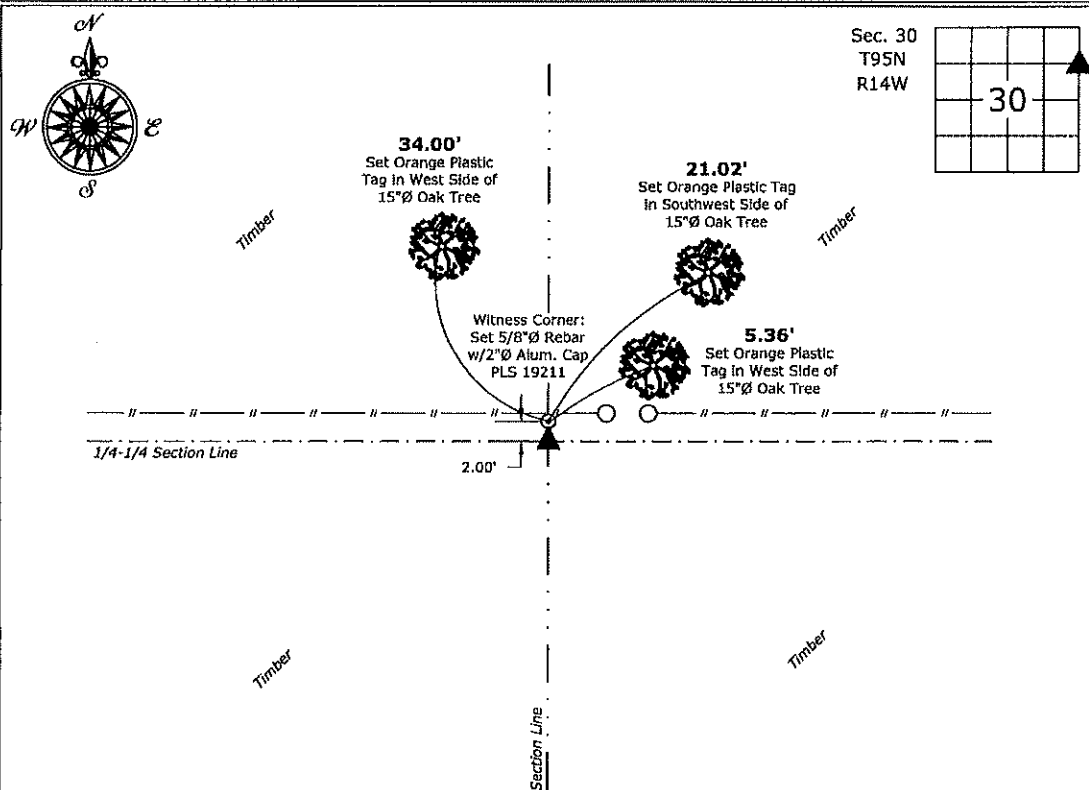

Cor. C1
 30-95-14

Southeast Corner of the NE 1/4 - NE 1/4 of Section 30-95-14
 Set 5/8"Ø Rebar w/2"Ø Aluminum Cap PLS 19211, 2.00' North on Section Line as a Witness Corner



I hereby certify that this land surveying document was prepared and the related survey work was performed by me or under my direct personal supervision and that I am a duly licensed Land Surveyor under the laws of the State of Iowa.

Kirk D. Reicks 6-29-2021
 Kirk D. Reicks Date:

License number 19211
 My license renewal date is December 31, 2022.
 Sheets covered by this seal: Individual sheet only

List Corner to be Indexed

Corner	Section	Twp.	Range
SE-NE-NE	30	95	14

Project Number: 2021-059

FB: Chickasaw 11, Pgs. 7-8

File: S:_Projects - NHO\County Control Systems - NHO\CHICKASAW\CHICK-32\CHICK-32 - 2020.dwg, 6/29/2021 8:41:29 AM