

UNITED STATES PUBLIC LAND SURVEY CORNER CERTIFICATE OF

Land Survey Monuments situated in Section 30, Township 95, Range 14, of the 5th Principal Meridian, Chickasaw County, Iowa. Previously recorded in Book (Drawer) N/A, Page (Document) N/A

In association with survey for: Steve Bouska

Chickasaw Co. Recorder
Cindy Messersmith
Fee Book 2013-2083
12/20/2013 @ 12:32 PM
SEC COR CERT
Book: _____ Page: _____
Total Fees: \$7.00 # Pages: _____

- Reason for preparing Certificate:
- There is no Certificate for the corner on file with the County Recorder.
 - Corner position differs from that previously recorded.
 - The corner monument has been replaced or modified.
 - The existing Certificate reference ties are incorrect or changed.






FOR RECORDER'S USE ONLY

Monument Description and Remarks:

- ① NW $\frac{1}{4}$ CORNER - Set $\frac{1}{2}$ " rebar w/red cap no. 11954 over found 3"x6"x8" Red Granite 2' deep. Stone in line with E-W fence remnant and centerline N-S road. Position of stone fits with long standing occupation of Southwest Quarter.
- ② NE CORNER NW $\frac{1}{4}$ -SW $\frac{1}{4}$ - Set $\frac{1}{2}$ " rebar w/red cap no. 11954 based on existing occupation of the Southwest Quarter.
- ③ SW CORNER NW $\frac{1}{4}$ -SW $\frac{1}{4}$ - Set $\frac{1}{2}$ " rebar w/red cap no. 11954 based on existing occupation of the Southwest Quarter.
- ④ SE CORNER NW $\frac{1}{4}$ -SW $\frac{1}{4}$ - Set $\frac{1}{2}$ " rebar w/red cap no. 11954 based on existing occupation of the Southwest Quarter.

DOCUMENT NO. 2013-1686

DOCUMENT NO. 2012-0842

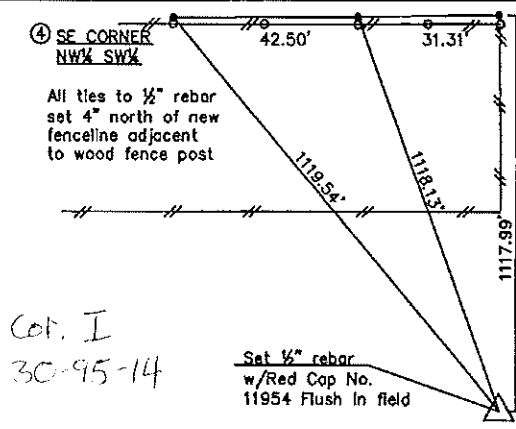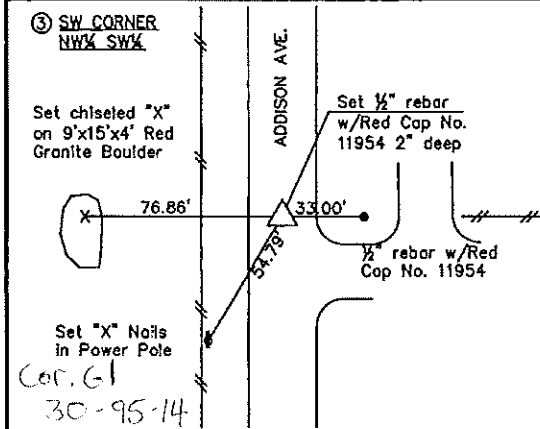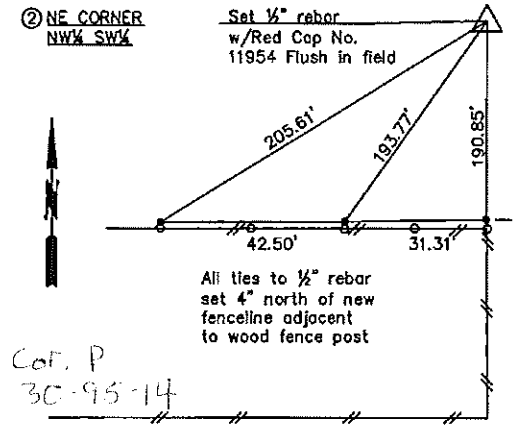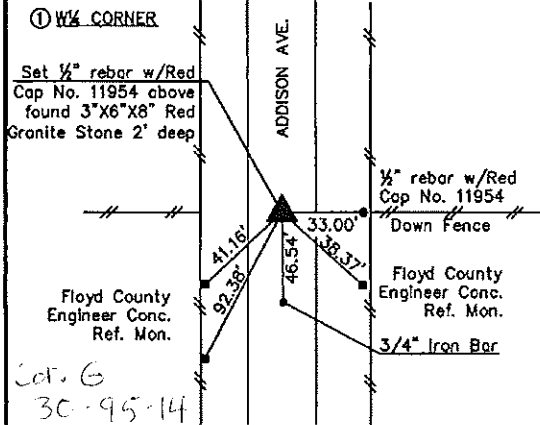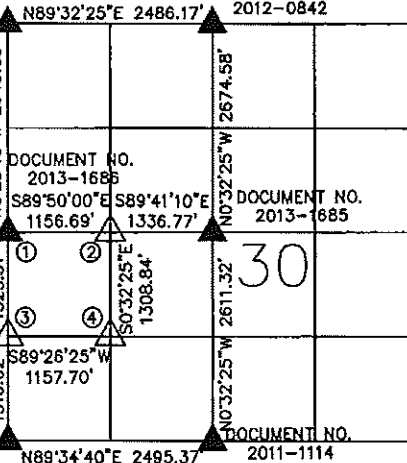

Certification:
I hereby certify that this land surveying document was prepared by me or under my direct personal supervision and that I am a duly licensed Land Surveyor under the laws of the State of Iowa

Daniel J. Johnson 12-14-13
Daniel J. Johnson Date
License Number 11954
My current license renewal date is Dec. 31, 2014

JOHNSON LAND SURVEYING
3703 165th Street, Blue Grass, IA 52726
Ph: (563) 506-8954

Corner Certificate Prepared By:
Daniel J. Johnson, L.S. #11954