



Prepared by & Return to: Herold - Reicks Surveying, 10 East Main Street, New Hampton, IA 50659, Ph. 641-394-2725

### United States Public Land Survey Corner Certificate

Land Survey Monument situated in  
 Section **30**, Township **95** North, Range **14** West of the Fifth Principal Meridian, **Chickasaw** County, Iowa.  
 Not on file in the County Recorder's office.

This certificate is being prepared in compliance with Iowa Code Chapter 355.11 because:


- There is no certificate on file for this corner.
- There are no longer three valid ties of record.
- There are changes to reference ties of record.
- There is change of monumentation of record.
- To clarify description of record monument (ties).

**Monument Description and Remarks:**

**Southwest Corner of the NE 1/4 - NE 1/4:** Found 4" x 6" Brown Granite Stone matching local occupation. Monument type is similar to other Monuments in the Section. Set 5/8"Ø Rebar w/2"Ø Aluminum Cap PLS 19211 West of Stone to add metal detection.

### Plan View

(Show a minimum of three reference ties to durable physical objects, relevant monuments and physical conditions that will enable recovery of the corner.)

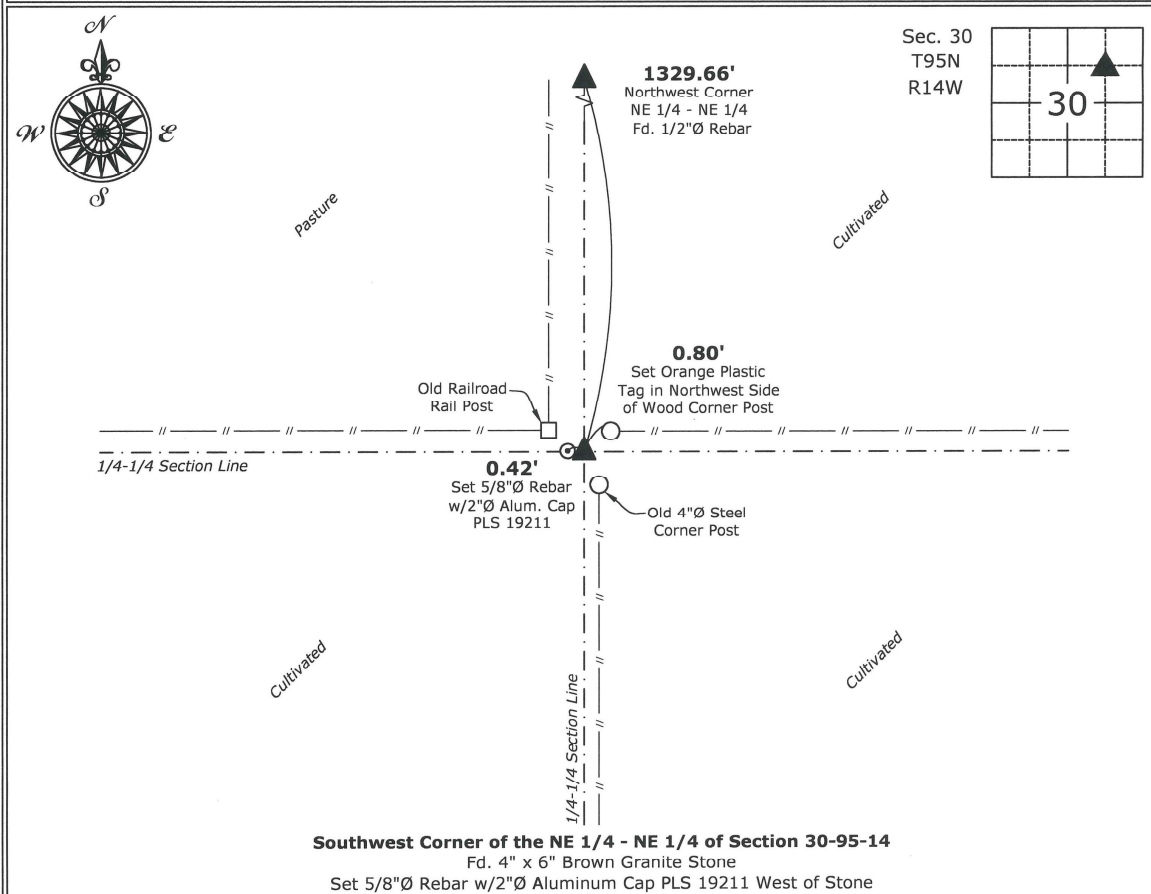

**Southwest Corner of the NE 1/4 - NE 1/4 of Section 30-95-14**  
 Fd. 4" x 6" Brown Granite Stone  
 Set 5/8"Ø Rebar w/2"Ø Aluminum Cap PLS 19211 West of Stone



I hereby certify that this land surveying document was prepared and the related survey work was performed by me or under my direct personal supervision and that I am a duly licensed Land Surveyor under the laws of the State of Iowa.

*Kirk D. Reicks* 6-29-2021  
 Kirk D. Reicks Date:

License number 19211  
 My license renewal date is December 31, 2022.  
 Sheets covered by this seal: Individual sheet only

| List Corner to be Indexed  |         |      |       |
|----------------------------|---------|------|-------|
| Corner                     | Section | Twp. | Range |
| SW-NE-NE                   | 30      | 95   | 14    |
| Project Number: 2021-059   |         |      |       |
| FB: Chickasaw 11, Pgs. 8-9 |         |      |       |