

Prepared by & Return to: Herold - Reicks Surveying, 10 East Main Street, New Hampton, IA 50659, Ph. 641-394-2725

## **United States Public Land Survey Corner Certificate**

Land Survey Monument situated in  
Section **36**, Township **95** North, Range **14** West of the Fifth Principal Meridian, **Chickasaw** County, Iowa.  
Not on file in the County Recorder's Office.

This certificate is being prepared in compliance with Iowa Code Chapter 355.11 because:


- There is no certificate on file for this corner.
- There are no longer three valid ties of record.
- There are changes to reference ties of record.
- There is change of monumentation of record.
- To clarify description of record monument (ties).

**Monument Description and Remarks:**


**West 1/4 Corner:** Found PK Nail with information obtained from Chickasaw County Engineer's Field Book  
Chickasaw Twp. Ties to Corners, Section 35, Corner C.

## Plan View

(Show a minimum of three reference ties to durable physical objects, relevant monuments and physical conditions that will enable recovery of the corner.)

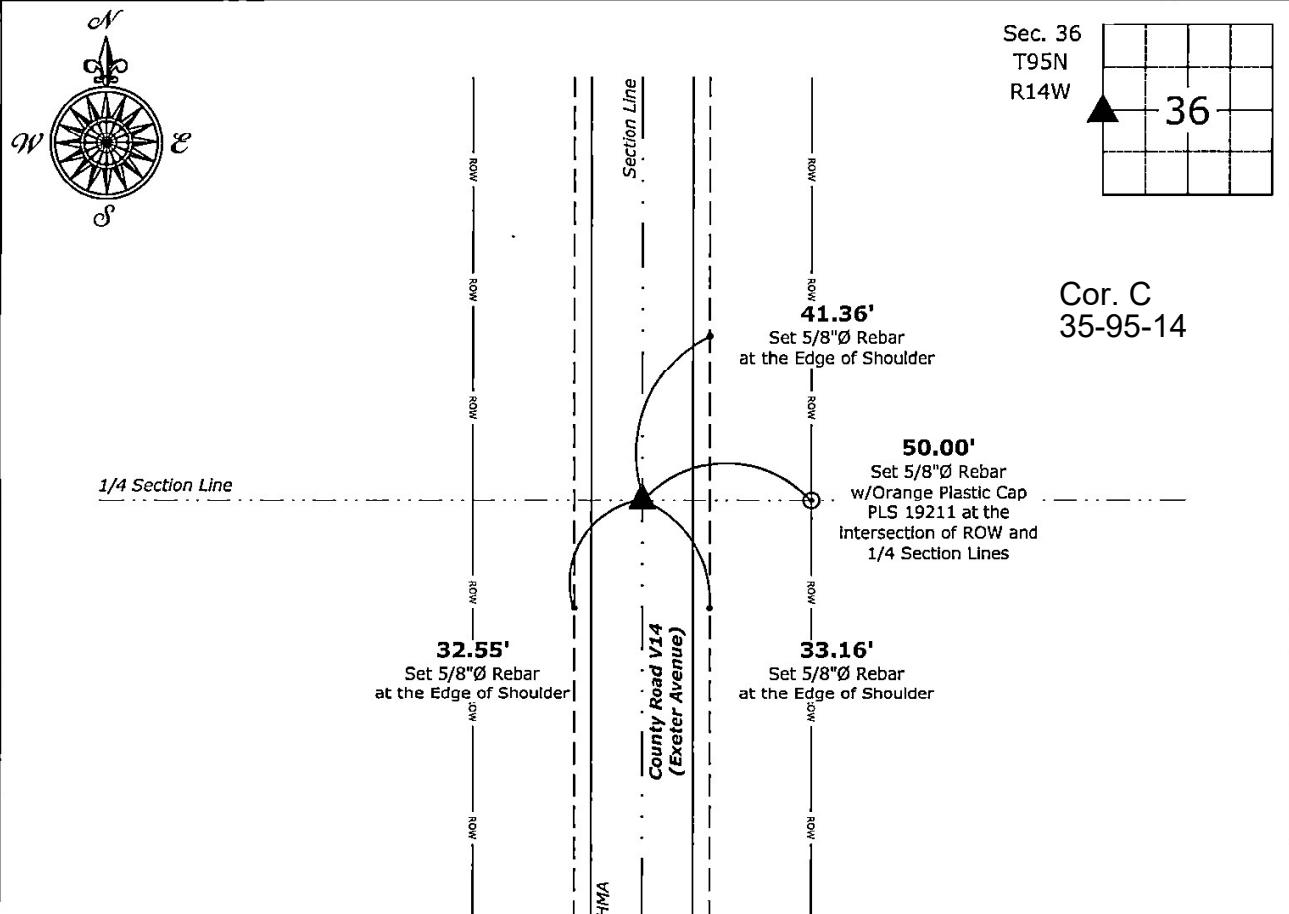

**West 1/4 Corner of Section 36-95-14**  
Found PK Nail

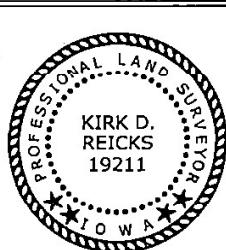

I hereby certify that this land surveying document was prepared and the related survey work was performed by me or under my direct personal supervision and that I am a duly licensed Land Surveyor under the laws of the State of Iowa.

Surveyed under the laws of the State of Iowa  
*K-10-2* 1-10-2003

Kirk D. Reicks

KIRK D. REICKS  
License number 19211

License number 19211  
My license renewal date is December 31, 2024.  
Sheets covered by this seal: Individual sheet o

24

### List Corner to be Indexed

Corner	Section	Twp.	Range
W 1/4	36	95	14

Project Number: 2022-162

FB: Chickasaw CO 11, Pgs. 73-75