

prepared by & Return to: Herold - Reicks Surveying, 10 East Main Street, New Hampton, IA 50659, Ph. 641-394-2725

UNITED STATES PUBLIC LAND SURVEY CORNER CERTIFICATE

Land Survey Monuments situated in Section ²⁵36, Township 95 North, Range 14 West of the Fifth Principal Meridian, Chickasaw County, Iowa. 1., 2.) Not previously recorded in the County Recorder's office.

This certificate is being prepared in compliance with Iowa Code Chapter 355.11 because:

- 1 & 2 There is no certificate on file for this corner.
 There are no longer three valid ties of record.
 There are changes to reference ties of record.
 There is change of monumentation of record.
 To clarify description of record monument (ties).


Monument Description and Remarks:

1.) North 1/4 Corner: Set 5/8"Ø rebar w/2"Ø aluminum cap PLS 19211 on line between the Northwest and Northeast Corners of said Section, and by doubling the distance from the Northeast Corner through and across the Northerly Extension of a possession line fence at the Northwest Corner of the NE 1/4 - NE 1/4 of said Section.

2.) East 1/4 Corner: Set 5/8"Ø rebar w/2"Ø aluminum cap PLS 19211 at the intersection of field divisions and the Centerline of Fayette Avenue.

PLAN - VIEW

(Show a minimum of three reference ties to durable physical objects, relevant monuments and physical conditions that will enable recovery of the corner.)

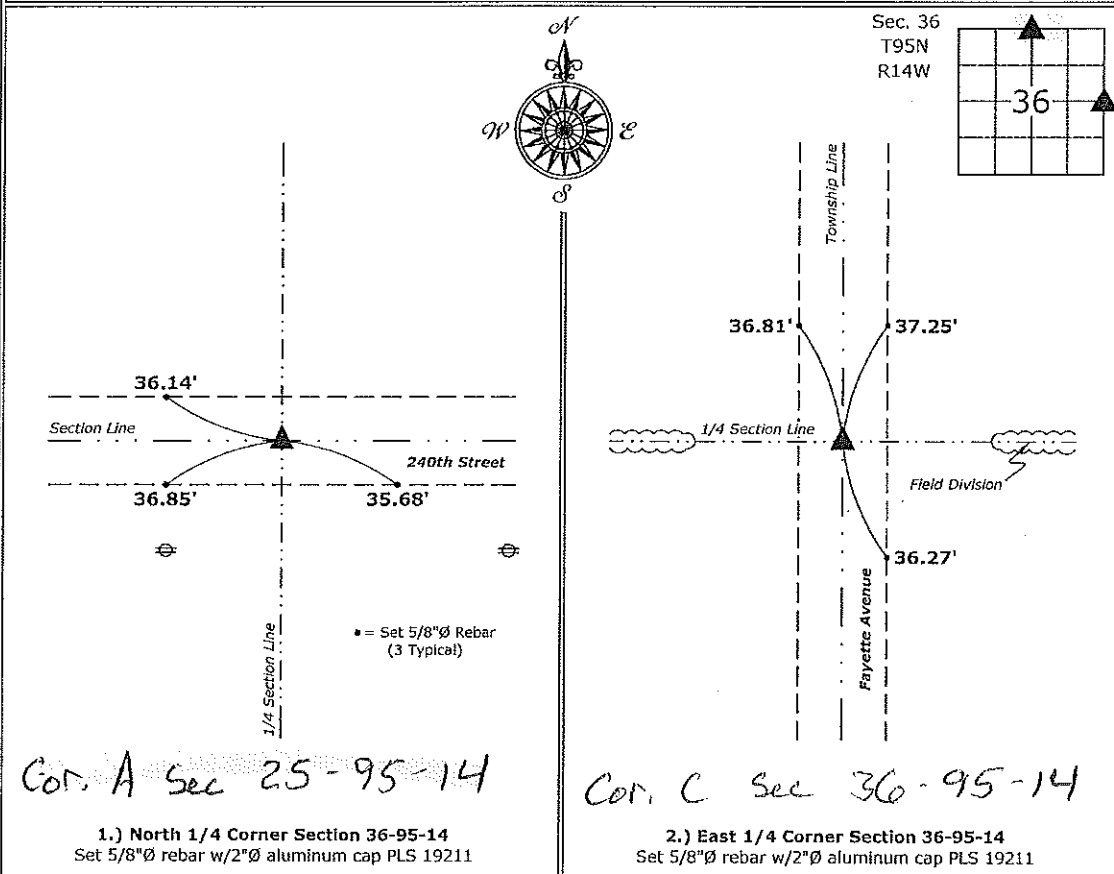


Cor. A Sec 25-95-14

Cor. C Sec 36-95-14

1.) North 1/4 Corner Section 36-95-14
 Set 5/8"Ø rebar w/2"Ø aluminum cap PLS 19211

2.) East 1/4 Corner Section 36-95-14
 Set 5/8"Ø rebar w/2"Ø aluminum cap PLS 19211

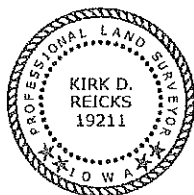

I hereby certify that this land surveying document was prepared and the related survey work was performed by me or under my direct personal supervision and that I am a duly licensed Land Surveyor under the laws of the State of Iowa.

Kirk D. Reicks 6-17-16
 Kirk D. Reicks Date:

License number 19211
 My license renewal date is December 31, 2016.
 Sheets covered by this seal: Individual sheet only

List Corners to be Indexed

Corners	Section	Twp.	Range
N 1/4	36	95	14
E 1/4	36	95	14

Project Number: 2016-082

FB: Chickasaw County 7, Pgs. 69