

UNITED STATES PUBLIC LAND
SURVEY CORNER CERTIFICATE OF
Land Survey Monuments situated in Section 3,
Township 95N, Range 14W of the 5th Principal Meridian,
Chickasaw County, Iowa.
Previously recorded in Book (Drawer) N/A, Page
(Document) N/A, in association with a survey for:
Karen Wegner

Chickasaw Co. Recorder
Cindy Messersmith
Fee Book 2017-0568
04/24/2017 @1005AM
SCC SEC COR CERT
Book: Page: # Pages: 1
Total Fees: \$7.00

Reason for preparing Certificate:

- There is no Certificate for the corner on file with the County Recorder.
- Corner position differs from that previously recorded.
- The corner monument has been replaced or modified.
- The existing Certificate reference ties are incorrect or changed.

Monument Description and Remarks:

① W 1/4 CORNER - Found 5" x 5" x 2" Red Granite, position matches existing occupation. Set $\frac{1}{2}$ " rebar against east face of stone.

② E 1/4 Corner - Set $\frac{1}{2}$ " rebar w/Red Cap No. 11954 from County Engineer's ties.

FOR RECORDER'S USE ONLY



DOCUMENT NO.
2003-2254

N89°28'10"E 5293.41' ② SC 54-001E 3287.76

① 3

DOCUMENT NO.
2003-2254

N147°20'W 2651.24'

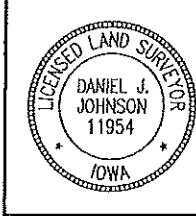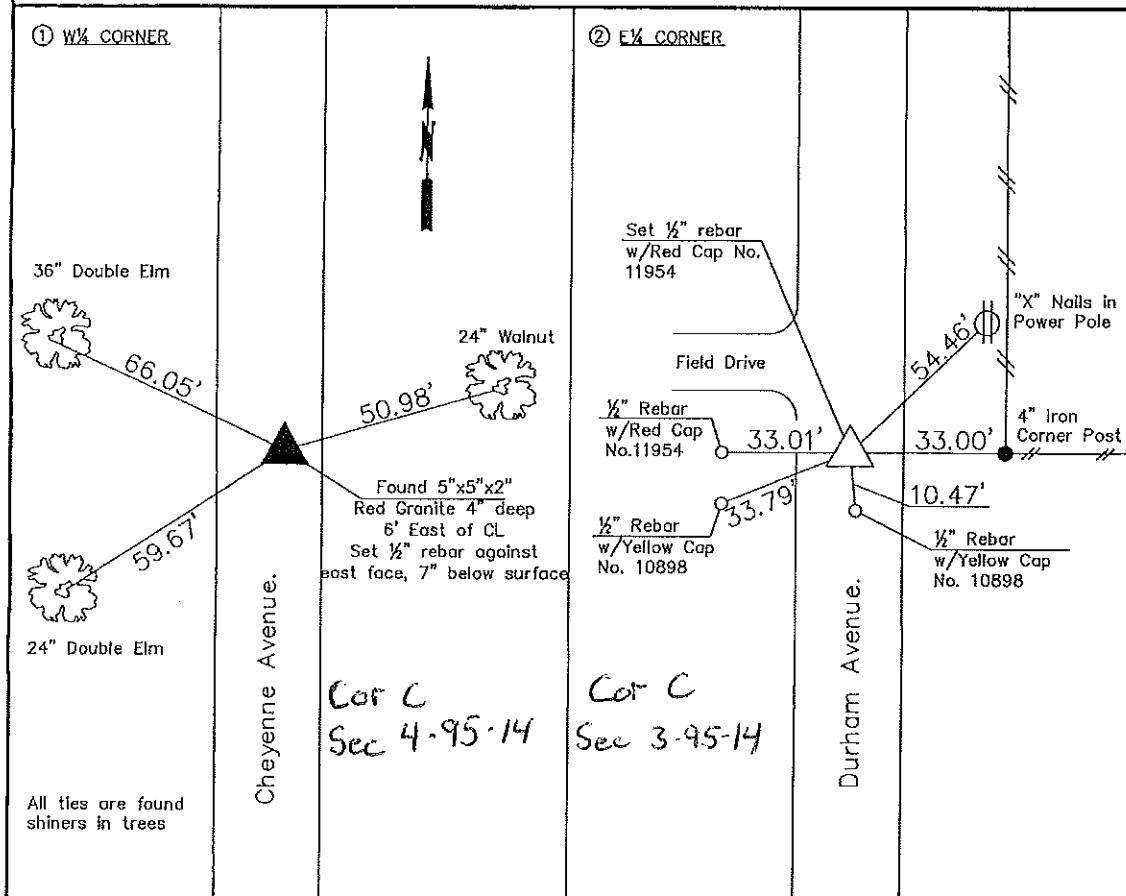

Certification:

I hereby certify that this land surveying document was prepared and the related survey work was performed by me or under my direct personal supervision and that I am a duly licensed Land Surveyor under the laws of the State of Iowa.

Daniel J. Johnson Date
Daniel J. Johnson
License number 11954
My current license renewal date is December 31, 2018

JOHNSON LAND SURVEYING
3703 165th Street, Blue Grass, IA 52726
Ph: (563) 506-9954

Corner Certificate Prepared By:
Daniel J. Johnson, L.S. #11954