
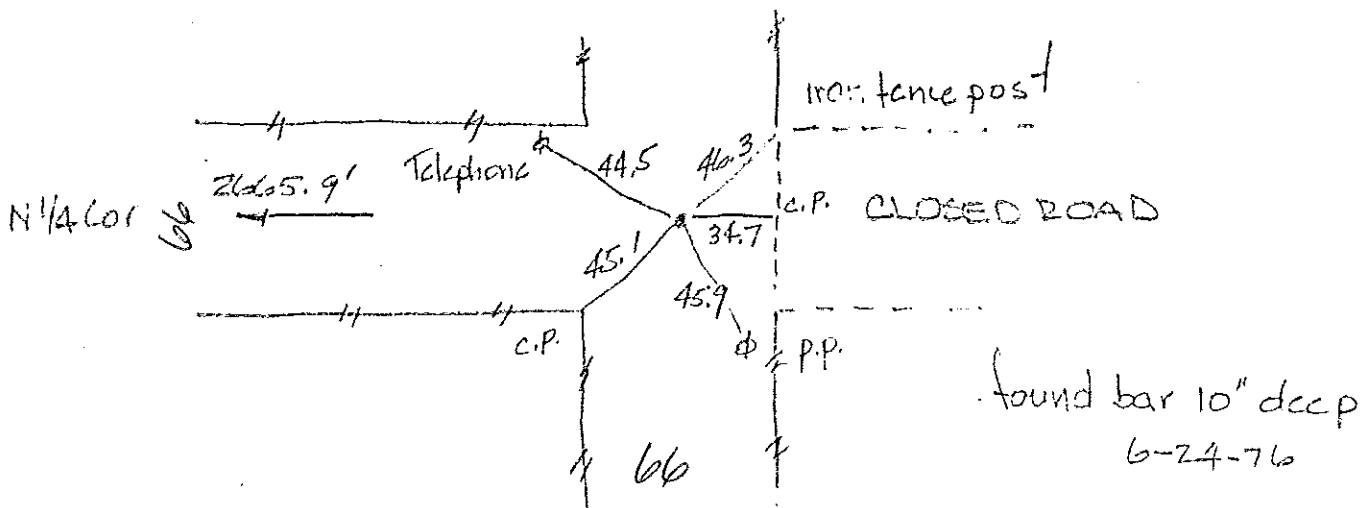


N.W. Cor 3-95-14 "B" 33-96-14

found bar 18" deep 6-24-76
new ties 6-24-76

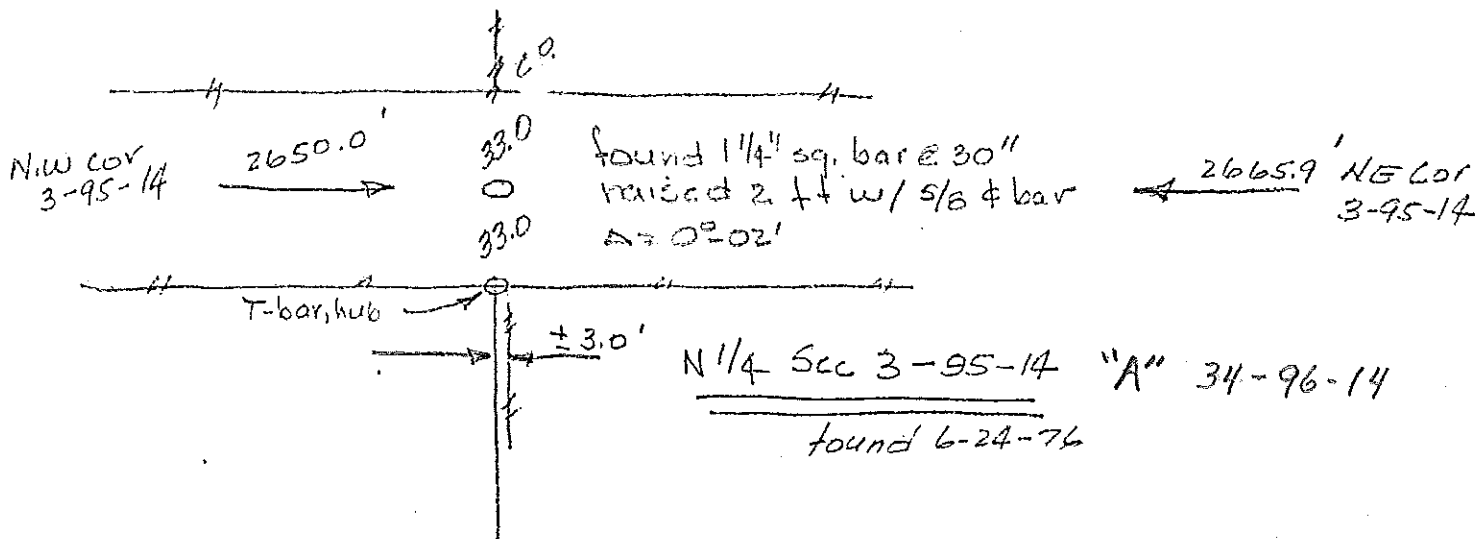

NE Cor 3-95-14

"B" 34-96-14

New Ties —

R.D. Hanson R.L.S.