

Chickasaw Co. Recorder  
 Cindy Messersmith  
**Fee Book 2008-0704**  
 04/18/2008 @0858AM  
 SCC SEC COR CERT  
 Book: Page: # Pages: 1  
 Total Fees: \$7.00

Section 32-96-14  
 As referred to in  
 Eng. Tax Book

**UNITED STATES PUBLIC LAND SURVEY CORNER CERTIFICATE**  
 OF 32 96

LAND SURVEY MONUMENTS SITUATED IN SECTION NO. 5, TOWNSHIP NO. 95 NORTH, RANGE  
 NO. 14 WEST OF THE FIFTH PRINCIPAL MERIDIAN, CHICKASAW COUNTY, IOWA.

PREVIOUSLY RECORDED IN N/A



(SHOW REASON FOR PREPARING THIS CERTIFICATE, THE EVIDENCE AND DETAILED PROCEDURES USED IN ESTABLISHING THE  
 CORNER POSITIONS AND MONUMENTATION FOUND OR PLACED.)

**MONUMENT DESCRIPTION AND REMARKS:**

FOUND NO CERTIFICATE ON FILE AT TIME OF SURVEY FOR THIS CORNER. FOUND SURVEY RECORDED IN  
 BOOK 139 PAGE 271 SHOWING 1/2" REBAR WITH CAP #7060 SET AT CORNER. SET POINT BY EXTENDING LINE  
 FROM NORTHEAST COR. SECTION 5 AND PINS ON SOUTH LINE SURVEY TO WEST AT RECORDED DIMENSION  
 FROM PLAT. SEARCHED AREA WITH METAL LOCATOR AND FOUND NOTHING. DUG HOLE SEVERAL FEET DEEP  
 AND FOUND NOTHING. WE THEN SET 1/2" REBAR WITH CAP #9018 ON LINE DESCRIBED ABOVE AND  
 RECORDED DIMENSION FROM PLAT.


**PLAN VIEW**

(SHOW A MINIMUM OF THREE REFERENCE TIES TO DURABLE PHYSICAL OBJECTS, RELEVANT MONUMENTS AND PHYSICAL  
 CONDITIONS THAT WILL ENABLE RECOVERY OF THE CORNER.)

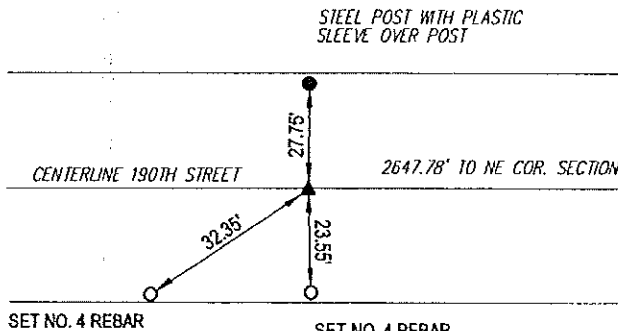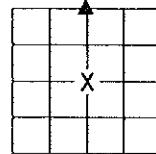

Cor A  
 32-96-14

**NORTH 1/4 CORNER 5-95-14**

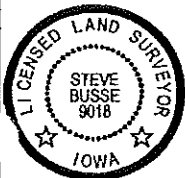

I HEREBY CERTIFY THAT THIS LAND SURVEYING DOCUMENT  
 WAS PREPARED AND THE RELATED SURVEY WORK WAS  
 PERFORMED BY ME OR UNDER MY DIRECT PERSONAL  
 SUPERVISION AND THAT I AM A DULY LICENSED LAND  
 SURVEYOR UNDER THE LAWS OF THE STATE OF IOWA.

*Steve Busse* 4/16/08  
 STEVE BUSSE DATE

LICENSE NUMBER 9018  
 MY LICENSE RENEWAL DATE IS DECEMBER 31, 2008  
 PAGES OR SHEETS COVERED BY THIS SEAL 1

G.P. = 2" GAS PIPE  
 CONC MONU = CONCRETE MONUMENT W/ PIN & ALUM CAP  
 OPT = PLASTIC TAG (O=ORANGE, Y=YELLOW)  
 (00) RECORDED AS

**LIST CORNERS TO BE INDEXED**

CORNER	SECTION	TOWNSHIP	RANGE
NORTH 1/4 COR.	5	95	14