

Instrument #: 2021-1127
 05/20/2021 03:59:47 PM Total Pages: 1
 SCC SECTION CORNER CERTIFICATES
 Recording Fee: \$ 7.00
 Shirley Treyna, Recorder, Chickasaw County Iowa

Prepared by & Return to: Herald - Reicks Surveying, 10 East Main Street, New Hampton, IA 50659, Ph. 641-394-2725

United States Public Land Survey Corner Certificate

Land Survey Monument situated in
 Section 6, Township 95 North, Range 14 West of the Fifth Principal Meridian, Chickasaw County, Iowa.
 Not on file in the County Recorder's office.

This certificate is being prepared in compliance with Iowa Code Chapter 355.11 because:


- There is no certificate on file for this corner.
- There are no longer three valid ties of record.
- There are changes to reference ties of record.
- There is change of monumentation of record.
- To clarify description of record monument (ties).

Monument Description and Remarks:

Southwest Corner of the Fr'l NW 1/4-NW 1/4: Set 5/8"Ø Rebar w/2"Ø Aluminum Cap PLS 19211 on line between the Northwest and West 1/4 Corners of said Section and on an old possession line fence running East. Fence was the best evidence of a Survey made by A.F. Kemmen, recorded in Range Book 14, Page 322, on file in the Chickasaw County Engineer's Office, New Hampton, Iowa.

Plan View

(Show a minimum of three reference ties to durable physical objects, relevant monuments and physical conditions that will enable recovery of the corner.)

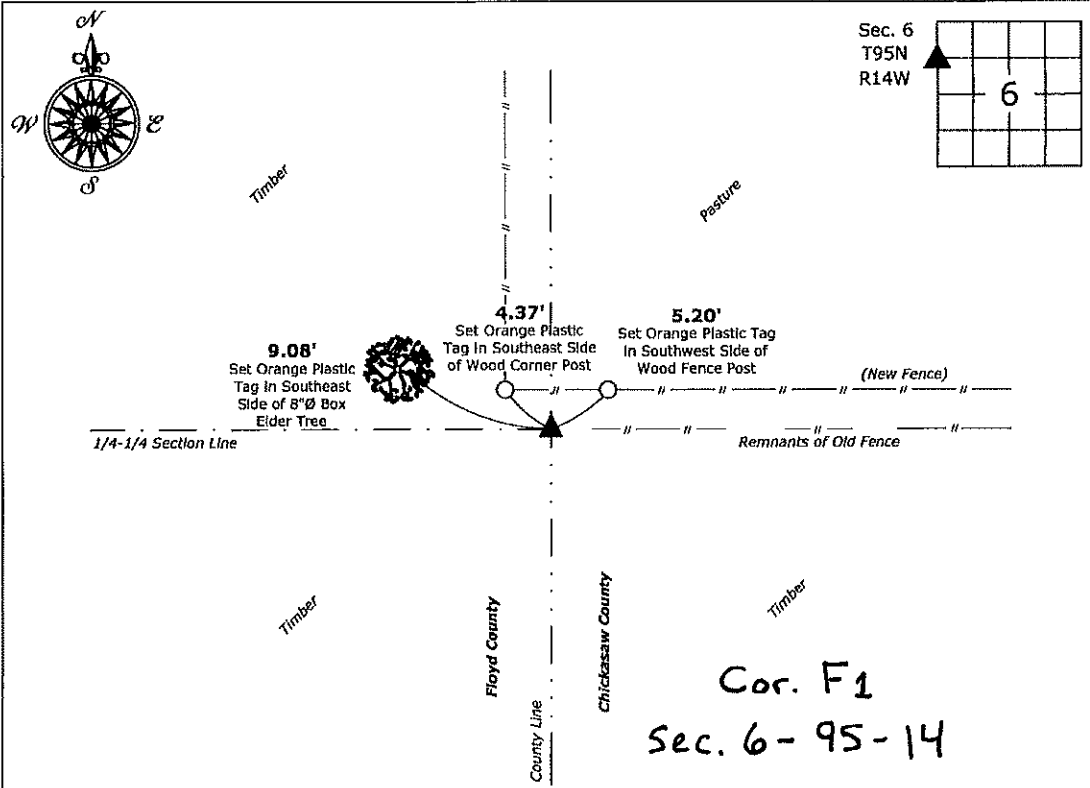

Southwest Corner of the Fr'l NW 1/4-NW 1/4 of Section 6-95-14
 Set 5/8"Ø Rebar w/2"Ø Aluminum Cap PLS 19211



I hereby certify that this land surveying document was prepared and the related survey work was performed by me or under my direct personal supervision and that I am a duly licensed Land Surveyor under the laws of the State of Iowa.

Kirk D. Reicks 5-18-2021
 Kirk D. Reicks Date:
 License number 19211
 My license renewal date is December 31, 2022.
 Sheets covered by this seal: Individual sheet only

List Corner to be Indexed			
Corner	Section	Twp.	Range
SW-NW-NW	6	95	14

Project Number: 2021-030
 FB: Chickasaw 11, Pgs. 1-2

File: S:_Projects - NHO\County Control Systems - NHO\CHICKASAW\CHICK-25\CHICK-25 - 2020.dwg, 5/18/2021 8:35:44 AM