


Instr. Number: 2026-0823
Recorded: 5/18/2026 at 3:10:56.0 PM
Pages 1
County Recording Fee: \$7.00
Iowa E-Filing Fee: \$3.00
Combined Fee: \$10.00
Revenue Tax:
Shirley Troyna RECORDER
Chickasaw County, Iowa

PREPARED BY/RETURN TO: MOORE LAND SERVICES, L.L.C., 13789 DOMINO ROAD, ELKADER, IA 52043 - PH: (563) 329-1051


UNITED STATES PUBLIC LAND SURVEY CORNER CERTIFICATE
SECTION 8, TOWNSHIP 95 NORTH, RANGE 14 WEST
OF THE FIFTH PRINCIPAL MERIDIAN, CHICKASAW COUNTY, IOWA

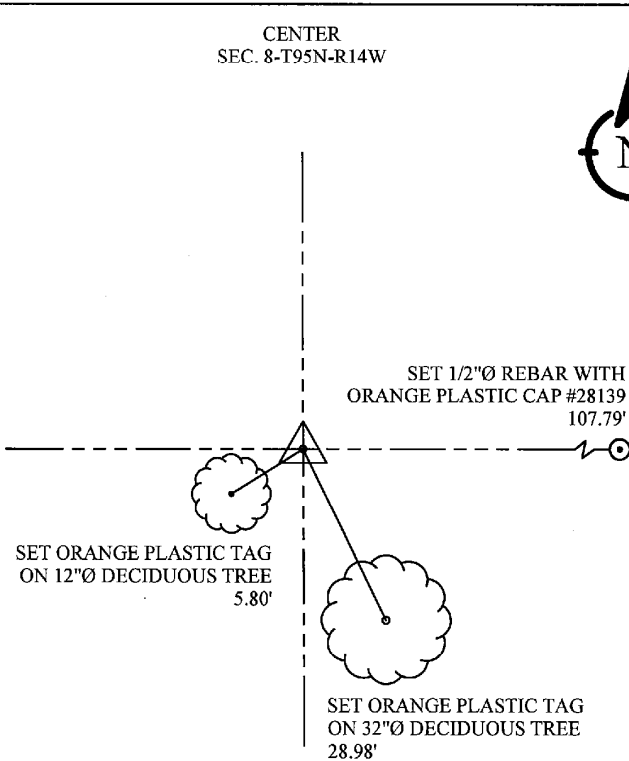

PREVIOUSLY RECORDED:
NO PREVIOUS CERTIFICATE ON FILE.

PURPOSE OF CERTIFICATE:
FOUND MONUMENT AT INTERSECTION OF THE QUARTER
SECTION LINES (E1/4 TO W1/4 AND N1/4 TO S1/4). ACCEPTED
MONUMENT SINCE THIS POSITION IS SHOWN ON SEVERAL
PREVIOUS PLATS OF SURVEY AND IS IN COHESION WITH
SAID PLATS.

MONUMENT DESCRIPTION AND ESTABLISHMENT:
FOUND 1/2"Ø REBAR

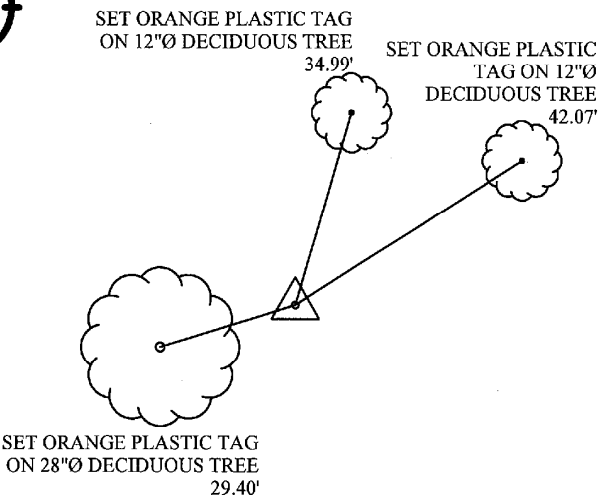

PREVIOUSLY RECORDED:
NO PREVIOUS CERTIFICATE ON FILE.

PURPOSE OF CERTIFICATE:
SET MONUMENT AT MIDPOINT BETWEEN THE CENTER OF
SECTION AND THE S1/4 CORNER AFTER REVIEWING
AVAILABLE INFORMATION, EVALUATING FIELD EVIDENCE,
AND SEARCHING AREA FOR EXISTING MONUMENTATION.

MONUMENT DESCRIPTION AND ESTABLISHMENT:
SET 1/2"Ø REBAR WITH ORANGE PLASTIC CAP #28139


CORNERS TO BE INDEXED

CENTER OF SECTION 8, TOWNSHIP 95, RANGE 14 WEST
&
SE CORNER OF THE NE1/4-SW1/4 OF SECTION 8, TOWNSHIP 95, RANGE 14 WEST



I hereby certify that this land surveying document was
prepared and the related survey work was performed by me
or under my direct personal supervision and that I am a
duly licensed Land Surveyor under the laws of the State of
Iowa.

Phillip J. Moore 5-18-2026
Phillip J. Moore, P.L.S. Date
License Number: 28139
My license renewal date is December 31, 2026.
Sheets covered by this seal: SHEET 1 OF 1

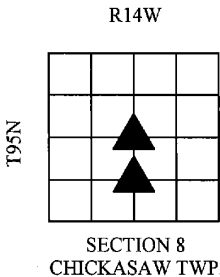

MOORE LAND SERVICES, L.L.C.
JOB NUMBER: 26-026
SURVEY COMPLETED ON: 5/14/2026
SHEET NUMBER: 1 of 1