

Chickasaw Co. Recorder
 Cindy Messersmith
Fee Book 2016-0348
 03/16/2016 @0928AM
 SCC SEC COR CERT
 Book: Page: # Pages: 1
 Total Fees: \$7.00

PREPARED BY / RETURN TO: KENNETH D. STARK IOWA DEPARTMENT OF TRANSPORTATION 426 43rd ST. SW MASON CITY, IA 50401 641-423-7584

UNITED STATES PUBLIC LAND SURVEY CORNER CERTIFICATE

OF

Land Survey Monuments situated in Section 10³, Township 95N, Range 14W
 of the Fifth Principal Meridian, CHICKASAW County, Iowa.

Previously recorded in NA in County Recorder's Office.
(book, page, document number, etc.)

(Show reason for preparing this certificate, the evidence and detailed procedures used in establishing the corner positions and monumentation found or placed.)

Monument Description and Remarks: NW CORNER: Replaced previously found SMN/IDOT washer with a SMN/IDOT Sec. Cor. washer, 3.1' +/- North of US 18 per IDOT information of record supplied by New Hampton Office after HMA resurfacing project MP-018-2(707)220-76-19.


Reason for cert: Monumentation and ties have changed.

N/4 CORNER: Replaced previously found SMN/IDOT washer with a SMN/IDOT Sec. Cor. washer, 1.2' +/- South of US 18 per IDOT information of record supplied by New Hampton Office after HMA resurfacing project MP-018-2(707)220-76-19.

Reason for cert: Monumentation and ties have changed.

PLAN - VIEW

(Show a minimum of three reference ties to durable physical objects, relevant monuments and physical conditions that will enable recovery of the corner.)

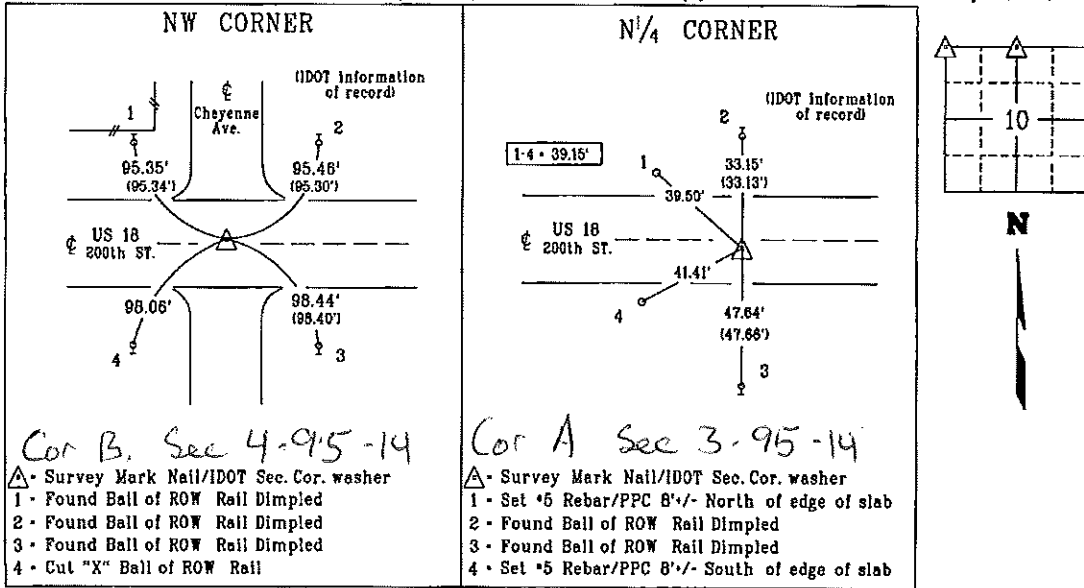

List Corners to be Indexed

| Corner | Section | Township | Range |
|------------|---------|----------|-------|
| NW CORNER | 10 | 95N | 14W |
| N/4 CORNER | 10 | 95N | 14W |

SMN - Survey Mark Nail
 PPC - Pink Plastic Cap

drawn by: cjs 02/15



I hereby certify that this land surveying document was prepared and the related survey work was performed by me or under my personal supervision and that I am duly licensed Land Surveyor under the laws of the state of Iowa.

Kenneth D. Stark 03-14-16
 Kenneth D. Stark Date
 License number 10898
 My License renewal date is December 31, 2017
 Pages or sheets covered by this seal. 1

Chickasaw Co. Recorder
 Cindy Messersmith
Fee Book 2014-0866
 07/08/2014 @10:57AM
 SCC: SEC COR CERT
 Book: Page: # Pages: 1
 Total Fees: \$7.00

Prepared by & Return to: Herold - Recks Surveying, 10 East Main Street, New Hampton, IA 50659, Ph. 641-394-2725

UNITED STATES PUBLIC LAND SURVEY CORNER CERTIFICATE

Land Survey Monuments situated in Section 3, Township 95 North, Range 13 West of the Fifth Principal Meridian, Chickasaw County, Iowa. Previously recorded in Bk. , Pg. in the County Recorder's office.

This certificate is being prepared in compliance with Iowa Code Chapter 355.11 because:

- 1 & 2 There is no certificate on file for this corner.
 There are no longer three valid ties of record.
 There are changes to reference ties of record.
 There is change of monumentation of record.
 To clarify description of record monument (ties).


Monument Description and Remarks:

1.) **Center of Section:** Fd. 12" X 9" Granite Stone, Set 5/8"Ø Rebar w/2"Ø Alum. Cap PLS 155225 0.54' South of Stone as Witness. There are Fence Remnants running East, West and North of this Corner and all lead to the Stone, the actual corner is 40 feet South of the Theoretical Position, but does match all of the field evidence, therefore accepted the Stone as the correct Center of Section.

2.) **S 1/4 Corner:** Fd. Survey Mark Nail w/I.D.O.T. Stainless Steel Washer.
 Corner was recovered from information obtained from the Iowa Iowa Department of Transportation, As-Built Plans Project No. FR-18-7(31)--26-19, the previous Alum. Disk was replaced after an HMA Overlay Project.

PLAN - VIEW

(Show a minimum of three reference ties to durable physical objects, relevant monuments and physical conditions that will enable recovery of the corner.)

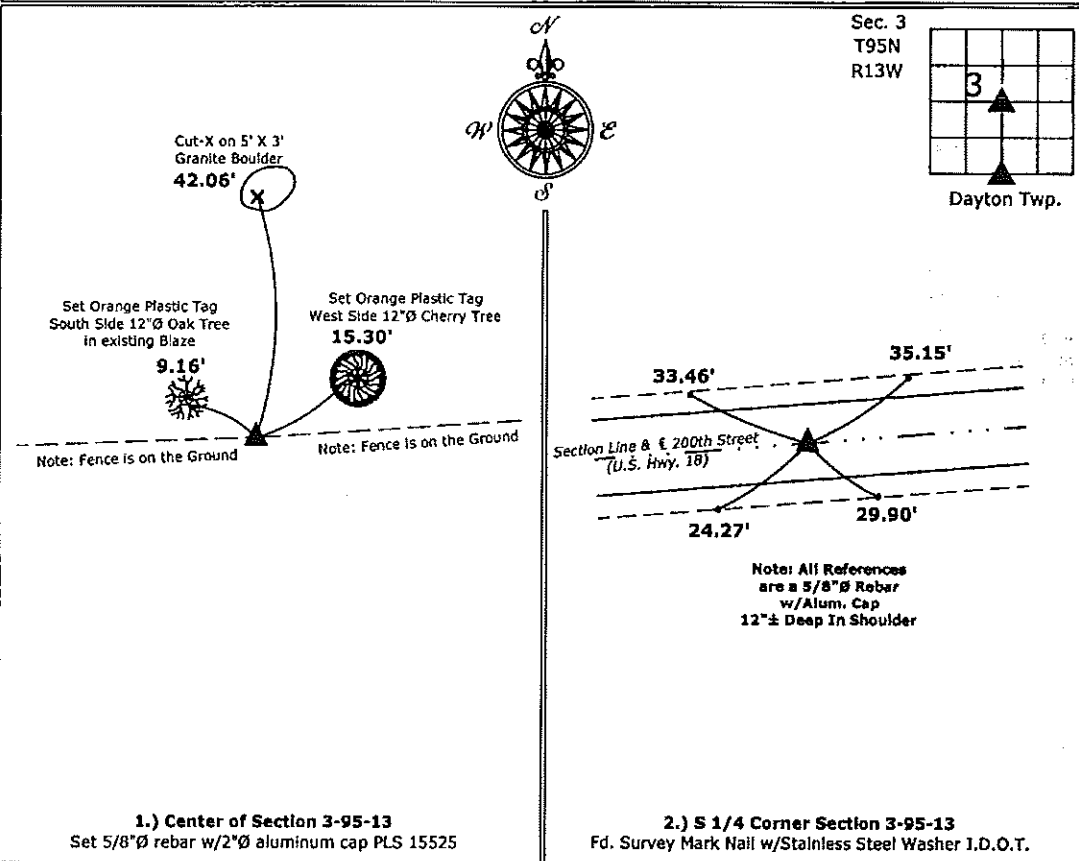

I hereby certify that this land surveying document was prepared and the related survey work was performed by me or under my direct personal supervision and that I am a duly licensed Land Surveyor under the laws of the State of Iowa.

Paul R. Herold 7-8-14
 Paul R. Herold Date:
 License number 15525
 My license renewal date is December 31, 2014.
 Sheets covered by this seal: Individual sheet only

| List Corners to be Indexed | | | |
|----------------------------|---------|------|-------|
| Corners | Section | Twp. | Range |
| CTR | 3 | 95 | 13 |
| S 1/4 | 3 | 95 | 13 |

Project Number: 2014-045
 FB: Chickasaw County 6, Pgs. 31-34

File: S:_CAD Projects\County Control Systems\CHICKASAW\CHICK-27\CHICK-27.dwg, 7/8/2014 10:38:54 AM