

Section 11-95-13
As referred to in
Eng. the Book

FILED 2005-1874

RECORDER'S OFFICE
HICKASAW COUNTY, IOWA

2005 AUG 31 AM 9 04

CINDY MESSERSMITH
COUNTY RECORDER

TeKIPPE ENGINEERING, P.C., 128 South Vine Street, West Union, Iowa 52175 Phone (563) 422-5131

UNITED STATES PUBLIC LAND SURVEY CORNER CERTIFICATE

OF //



Land Survey Monuments situated in Section 12, Township 95 North, Range 13 West of the Fifth Principal Meridian, CHICKASAW County, Iowa. Previously recorded in none in County Recorder's Office. (book, page, document number, etc.)

(Show reason for preparing this certificate, the evidence and detailed procedures used in establishing the corner positions and monumentation found or placed.)

Monument Description and Remarks: SW CORNER SECTION 12 T95N R13W: Found PK nail with information obtained from the Chickasaw County Engineer's Office in Field Book Dayton Twp. Corner Ties, Section 11, Corner 'B'.

PLAN - VIEW

(Show a minimum of three reference ties to durable physical objects, relevant monuments and physical conditions that will enable recovery of the corner.)

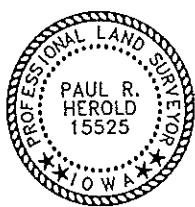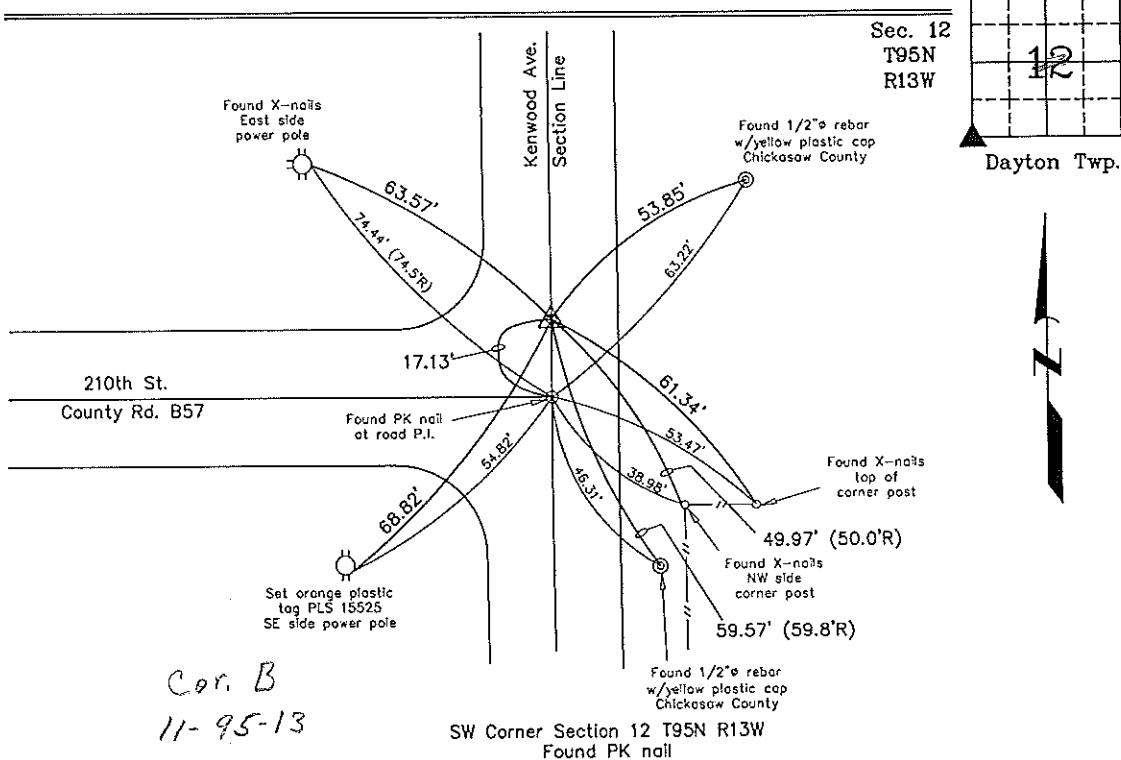

I hereby certify that this land surveying document was prepared and the related survey work was performed by me or under my direct personal supervision and that I am a duly licensed Land Surveyor under the laws of the State of Iowa.

Paul R. Herold 8-29-05

Paul R. Herold Date
License number 15525
My license renewal date is December 31, 2006.
Sheets covered by this seal: Individual

Corners	Section	Twp.	Range
SW	12	95N	13W

X:\Section Corners\Sec. 12112-95-13u.dwg

FILED 2003-2239

RECORDER'S OFFICE
CHICKASAW COUNTY, IOWAJUL 17 2003
AM 9 08CINDY MESSERSMITH
COUNTY RECORDER

Harlan K. Schuck, L.S., Ryken Engineering, 711 Park Avenue, Ackley, IA 50601-Ph. 641-847-3273

Section 11-95-13
As referred to in
Eng'g Tie Book


UNITED STATES PUBLIC LAND SURVEY CORNER CERTIFICATE
OFLand Survey Monuments situated in Section 14, Township 95, Range 14, of the Fifth Principal Meridian, CHICKASAW County, Iowa,Previously recorded in Not Applicable in County Recorder's Office

(Show reason for preparing this certificate, the evidence and detailed procedures used in establishing the corner positions and monumentation found or placed.)

Monument Description and Remarks: Used NE. coh to tie in survey in NE 1/4No certificate or fileNE Cor. - Found Pk Nail in A.C. paving or set by County 9-98Matches tier of record as per Co. Eng'r.

PLAN VIEW

(Show a minimum of three reference ties to durable physical objects, relevant monuments, and physical conditions that will enable recovery of the corner.)

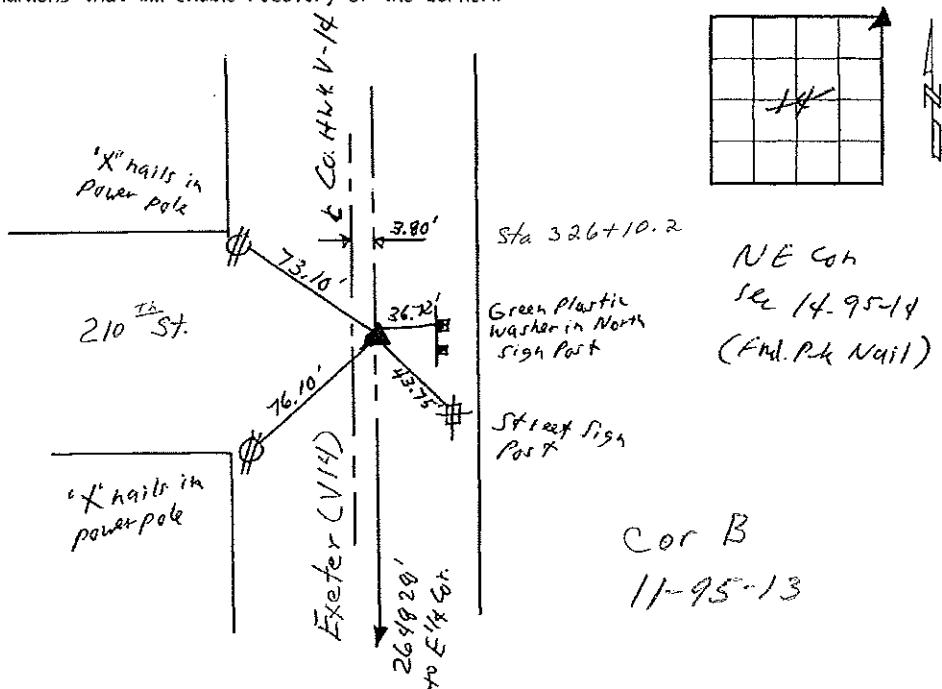

I hereby certify that this land surveying document was prepared and the related survey work was performed by me or under my direct personal supervision and that I am a duly licensed Land Surveyor under the laws of the State of Iowa.

Harlan K. Schuck

HARLAN K. SCHUCK
Date: 7-2-03 License number: 9962
My license renewal date is December 31, 2003

Corners	Section	Twp	Range
NE	14	95 N	14 W

Filed 8-13-03

LICENSED LAND SURVEYOR
HARLAN K.
SCHUCK
#9962

IOWA

Pages or sheets covered by this seal: 1