

Prepared by & Return to Herold - Recks Surveying, 10 East Main Street, New Hampton, IA 50659, Ph. 641-591-2725

UNITED STATES PUBLIC LAND SURVEY CORNER CERTIFICATE

Land Survey Monuments situated in Section ¹⁷16, Township 95 North, Range 13 West of the Fifth Principal Meridian, Chickasaw County, Iowa. Not previously recorded in the County Recorder's office.

This certificate is being prepared in compliance with Iowa Code Chapter 355.11 because:


- There is no certificate on file for this corner.
- There are no longer three valid ties of record.
- There are changes to reference ties of record.
- There is change of monumentation of record.
- To clarify description of record monument (ties).

Monument Description and Remarks:

West 1/4 Corner: Set 5/8"Ø rebar w/2"Ø aluminum cap PLS 15525 at the intersection of possession lines extended from the West 1/4 Corner of Section 17 to the approximate Southwest Corner SE 1/4-NE 1/4 and from the Northwest Corner of Section 16 through the approximate Northwest Corner SW 1/4-NW 1/4. A diligent effort was made to locate the stone shown on a survey and plat made by G. H. Elliot, February 6, 1912 in the Engineers Survey Record Book. This corner position compares favorably with the distances on said plat.

PLAN - VIEW

(Show a minimum of three reference ties to durable physical objects, relevant monuments and physical conditions that will enable recovery of the corner.)

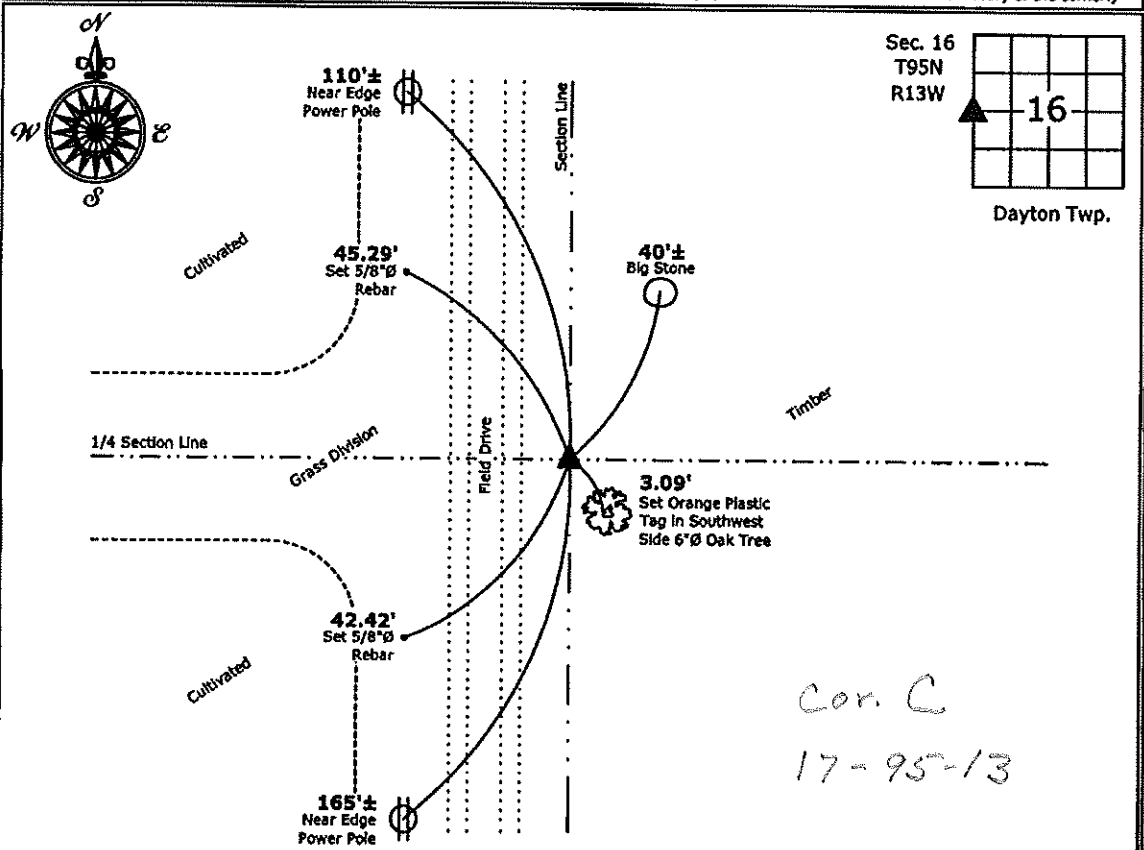

West 1/4 Corner Section 16-95-13
 Set 5/8"Ø rebar w/2"Ø aluminum cap PLS 15525



I hereby certify that this land surveying document was prepared and the related survey work was performed by me or under my direct personal supervision and that I am a duly licensed Land Surveyor under the laws of the State of Iowa.

Paul R. Herold 1-2-13
 Paul R. Herold Date:

License number 15525
 My license renewal date is December 31, 2014.
 Sheets covered by this seal: Individual sheet only

List Corners to be Indexed			
Corners	Section	Twp.	Range
WQ	16	95	13

Project Number: 2012-203
 FB: Chickasaw County 4, Pg. 78