

2001 OCT 11 AM 8 38

CINDY MESSERSMITH
COUNTY RECORDER

TeKIPPE ENGINEERING, P.C., 128 South Vine Street, West Union, Iowa 52175 Phone (663) 422-5131

UNITED STATES PUBLIC LAND SURVEY CORNER CERTIFICATE

OF

Land Survey Monuments situated in Section 7, Township 95 North, Range 13 West of the Fifth Principal Meridian, CHICKASAW County, Iowa.

Previously recorded in none in County Recorder's Office.
(book, page, document number, etc.)

(Show reason for preparing this certificate, the evidence and detailed procedures used in establishing the corner positions and monumentation found or placed.)


Monument Description and Remarks: E 1/4 Corner Section 7 T95N R13W: Found 1/2" twisted square iron bar with information obtained from the Chickasaw County Engineer's Office in the Field Book Dayton Twp. Corner Ties, Section 7, Corner C.

SE Corner Section 7 T95N R13W: Found 1/2" iron pin with information obtained from the Chickasaw County Engineer's Office in the Field Book Dayton Twp. Corner Ties, Section 7, Corner B.

PLAN - VIEW


Project Number 01194.LS
FR. 48H PG. 57-58

(Show a minimum of three reference ties to durable physical objects, relevant monuments and physical conditions that will enable recovery of the corner.)

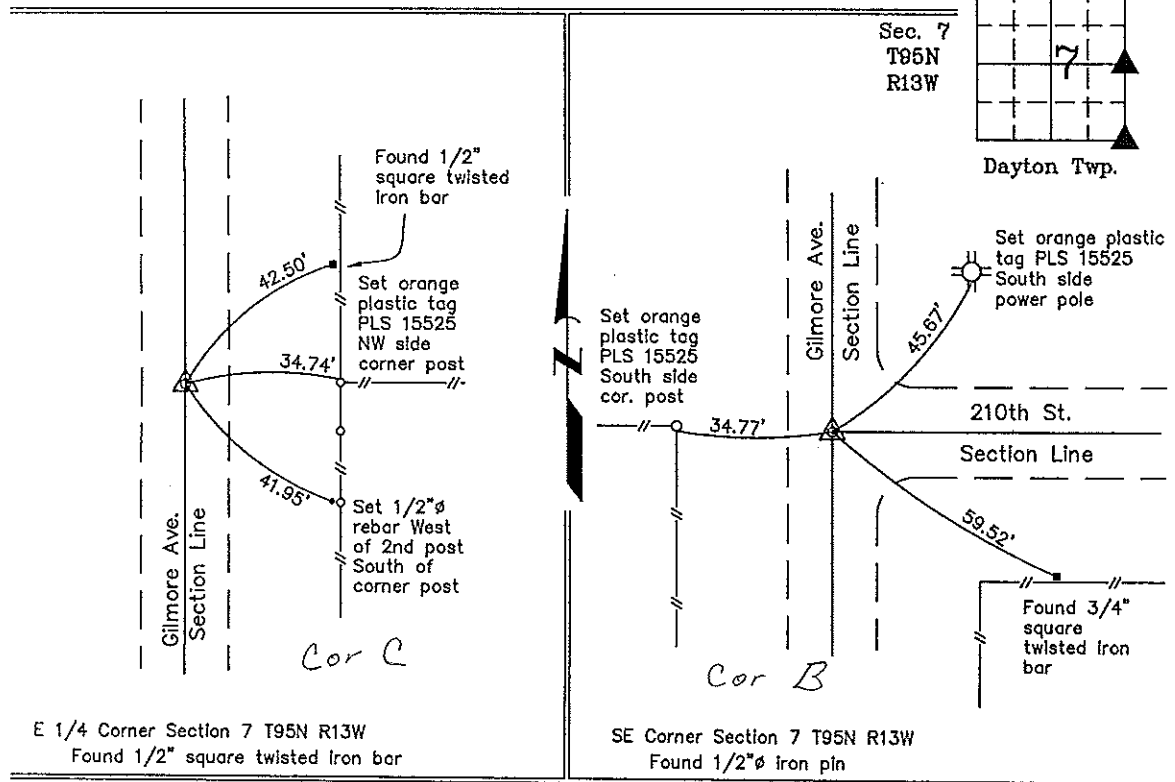

E 1/4 Corner Section 7 T95N R13W
Found 1/2" square twisted iron bar

SE Corner Section 7 T95N R13W
Found 1/2" iron pin

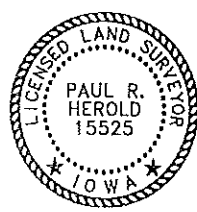

I hereby certify that this land surveying document was prepared and the related survey work was performed by me or under my direct personal supervision and that I am a duly licensed Land Surveyor under the laws of the State of Iowa.
Paul R. Herold 10-9-01
Paul R. Herold Date
License number 15525
My license renewal date is December 31, 2002.
Sheets covered by this seal: Individual

List Corners to be Indexed			
Corners	Section	Twp.	Range
E 1/4	7	95N	13W
SE	7	95N	13W

Filed 10-11-01

County Engineers
Cody