

Chickasaw Co. Recorder
 Cindy Messersmith
Fee Book 2016-1628
 11/30/2016 @12:46PM
 SCC: SEC COR CERT # Pages: 1
 Total Fees: \$7.00

Prepared by & Return to: Herald - Reicks Surveying, 10 East Main Street, New Hampton, IA 50659, Ph. 641-394-2725

United States Public Land Survey Corner Certificate

Land Survey Monument situated in
 Section 19, Township 95 North, Range 13 West of the Fifth Principal Meridian, Chickasaw County, Iowa.
 Not on file in the County Recorder's office.

This certificate is being prepared in compliance with Iowa Code Chapter 355.11 because:


- There is no certificate on file for this corner.
- There are no longer three valid ties of record.
- There are changes to reference ties of record.
- There is change of monumentation of record.
- To clarify description of record monument (ties).

Monument Description and Remarks:

Center: Set 5/8"Ø rebar w/2"Ø aluminum cap PLS 19211 on line between the West 1/4 Corner and East 1/4 Corner of said Section and by the doubling the distance from the East 1/4 Corner to the Northwest Corner NE 1/4 - SE 1/4.

Plan View

(Show a minimum of three reference ties to durable physical objects, relevant monuments and physical conditions that will enable recovery of the corner.)

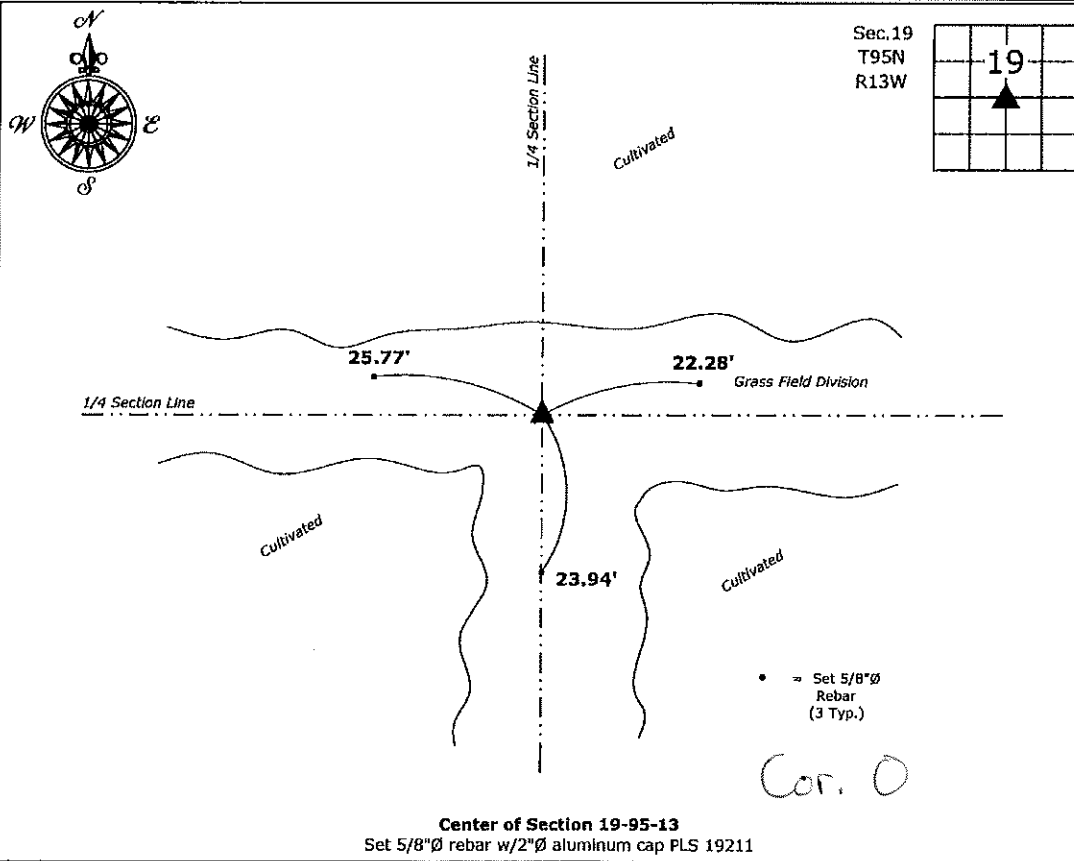

I hereby certify that this land surveying document was prepared and the related survey work was performed by me or under my direct personal supervision and that I am a duly licensed Land Surveyor under the laws of the State of Iowa.
Kirk D. Reicks 11-30-16
 Kirk D. Reicks Date:
 License number 19211
 My license renewal date is December 31, 2016.
 Sheets covered by this seal: Individual sheet only

List Corner to be Indexed			
Corner	Section	Twp.	Range
CTR	19	95	13

Project Number: 2016-117
 FB: Chickasaw 8, Pgs. 13-14

File: S:_C3D Projects\County Control Systems\CHICKASAW\CHICK-34\CHICK-34.dwg, 11/30/2016 10:53:57 AM