

>
Chickasaw Co. Recorder
Cindy Messersmith
Fee Book 2016-1629
11/30/2016 01247PM
SCC SEC COR CERT
Book: Page: # Pages: 1
Total Fees: \$7.00

Prepared by & Return to: Herald - Reicks Surveying, 10 East Main Street, New Hampton, IA 50659, Ph. 641-394-2725

United States Public Land Survey Corner Certificate

Land Survey Monument situated in
Section 19, Township 95 North, Range 13 West of the Fifth Principal Meridian, **Chickasaw** County, Iowa.
Not on file in the County Recorder's office.

This certificate is being prepared in compliance
with Iowa Code Chapter 355.11 because:

- There is no certificate on file for this corner.
- There are no longer three valid ties of record.
- There are changes to reference ties of record.
- There is change of monumentation of record.
- To clarify description of record monument (ties).


Monument Description and Remarks:

Northwest Corner NE 1/4 - SE 1/4: Set 5/8"Ø rebar w/2"Ø aluminum cap PLS 19211 at an existing wood corner post
after comparing the position to adjacent corners in said Section.

An extensive search of all of the records within the County offices was performed as part of the section corner recovery,
No records were located of the perpetuation of a monument at this corner.

Plan View

(Show a minimum of three reference ties to durable physical objects, relevant monuments and physical conditions that will enable recovery of the corner.)

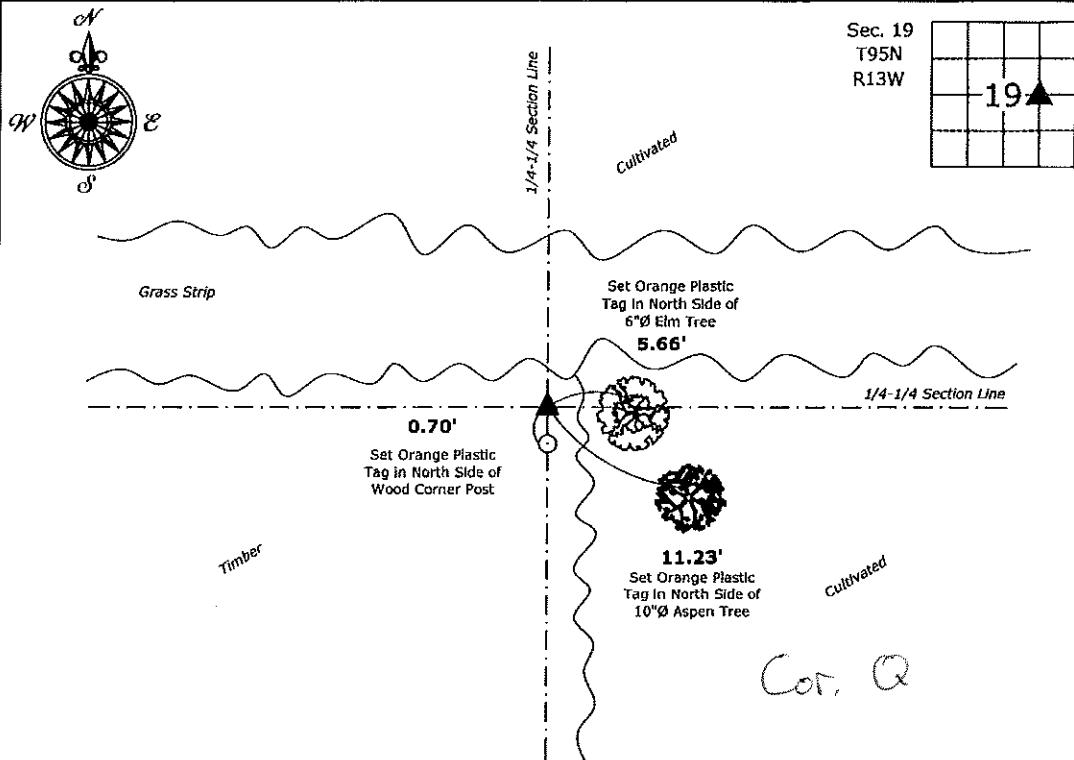

Northwest Corner NE 1/4 - SE 1/4 of Section 19-95-13
Set 5/8"Ø rebar w/2"Ø aluminum cap PLS 19211



I hereby certify that this land surveying document
was prepared and the related survey work was
performed by me or under my direct personal
supervision and that I am a duly licensed Land
Surveyor under the laws of the State of Iowa.

Kirk D. Reicks 11-30-16
Kirk D. Reicks Date:

License number 19211

My license renewal date is December 31, 2016.
Sheets covered by this seal: Individual sheet only

List Corner to be Indexed

Corner	Section	Twp.	Range
NW-NE-SE	19	95	13

Project Number: 2016-117

FB: Chickasaw 8, Pgs. 13-14