

Prepared by & Return to: Herold - Reicks Surveying, 10 East Main Street, New Hampton, IA 50659, Ph. 641-394-2725

**UNITED STATES PUBLIC LAND SURVEY CORNER CERTIFICATE**

Land Survey Monuments situated in Section 21, Township 95 North, Range 13 West of the Fifth Principal Meridian, Chickasaw County, Iowa. 1.) Previously recorded in Bk. 160, Pg.253 in the County Recorder's office. 2.) Previously not recorded in the County Recorder's office.

This certificate is being prepared in compliance with Iowa Code Chapter 355.11 because:

- 2  There is no certificate on file for this corner.
- There are no longer three valid ties of record.
- 1  There are changes to reference ties of record.
- 1  There is change of monumentation of record.
- To clarify description of record monument (ties).


**Monument Description and Remarks:**

**1.) North 1/4 Corner:** Previous monument was obliterated due to farming operations. Set 5/8"Ø rebar with 2"Ø aluminum cap PLS 19211 at previous location by means of coordinates obtained from a previous Survey and Plat made by Paul R. Herold, recorded December 4, 2012, Doc. #2012-2435 on file in the County Recorders Office. (Coordinates on file at the office of Herold-Reicks Surveying, New Hampton, Iowa)

**2.) Northeast Corner NW 1/4-NE 1/4:** Set 5/8"Ø rebar with 2"Ø aluminum cap PLS 19211 equidistant and online between the North 1/4 and Northeast Corners of Section 21.

**PLAN - VIEW**

(Show a minimum of three reference ties to durable physical objects, relevant monuments and physical conditions that will enable recovery of the corner.)

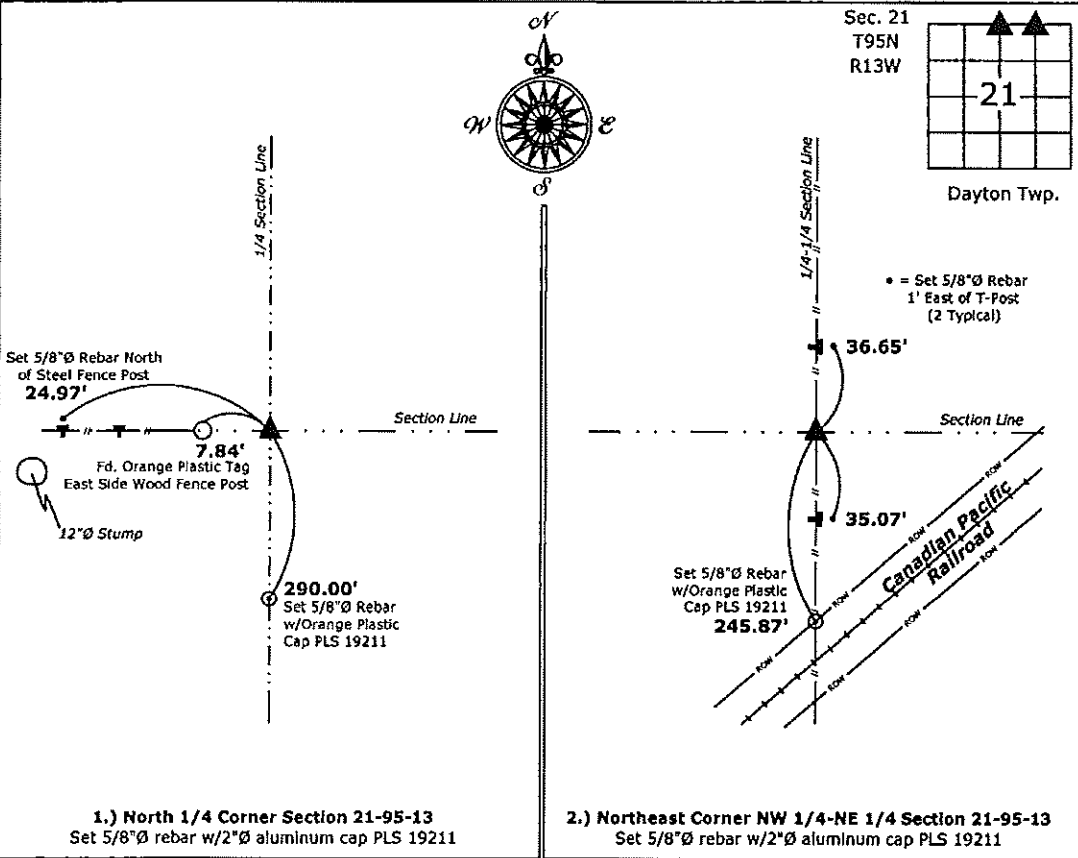

I hereby certify that this land surveying document was prepared and the related survey work was performed by me or under my direct personal supervision and that I am a duly licensed Land Surveyor under the laws of the State of Iowa.

*Kirk D. Reicks 1-14-15*  
 Kirk D. Reicks Date:  
 License number 19211  
 My license renewal date is December 31, 2016.  
 Sheets covered by this seal: Individual sheet only

List Corners to be Indexed			
Corners	Section	Twp.	Range
N 1/4	21	95	13
NE-NW-NE	21	95	13

Project Number: 2014-261  
 FB: Chickasaw County 7, Pgs. 19-20

File: S:\\_C3D Projects\County Systems\CHICKASAW\CHICK-34\CHICK-34.dwg, 1/13/2015 11:23:05 AM