

Herold - Recks Surveying, 10 East Main Street, New Hampton, IA 50659, Ph. 641-394-2725, Fax. 641-394-2710

UNITED STATES PUBLIC LAND SURVEY CORNER CERTIFICATE

Land Survey Monuments situated in Section 23, Township 95 North, Range 13 West of the Fifth Principal Meridian, Chickasaw County, Iowa. 1. & 2. Previously not recorded in the Chickasaw County Recorder's office.

This certificate is being prepared in compliance with Iowa Code Chapter 355.11 because:

- 1.) & 2.) There are no certificates on file for these corners.
 There are no longer three valid ties of record.
 There are changes to reference ties of record.
 There is change of monumentation of record.
 To clarify description of record monument (ties).


Monument Description and Remarks:

1.) SW Corner NW 1/4-SW 1/4: Set 5/8"Ø rebar w/2"Ø aluminum cap equidistant and online between the West 1/4 and the Southwest Corners of section.

2.) SE Corner NW 1/4-SW 1/4: Set 5/8"Ø rebar w/2"Ø aluminum at the intersection of 1/4-1/4 Section Lines.

PLAN - VIEW

(Show a minimum of three reference ties to durable physical objects, relevant monuments and physical conditions that will enable recovery of the corner.)

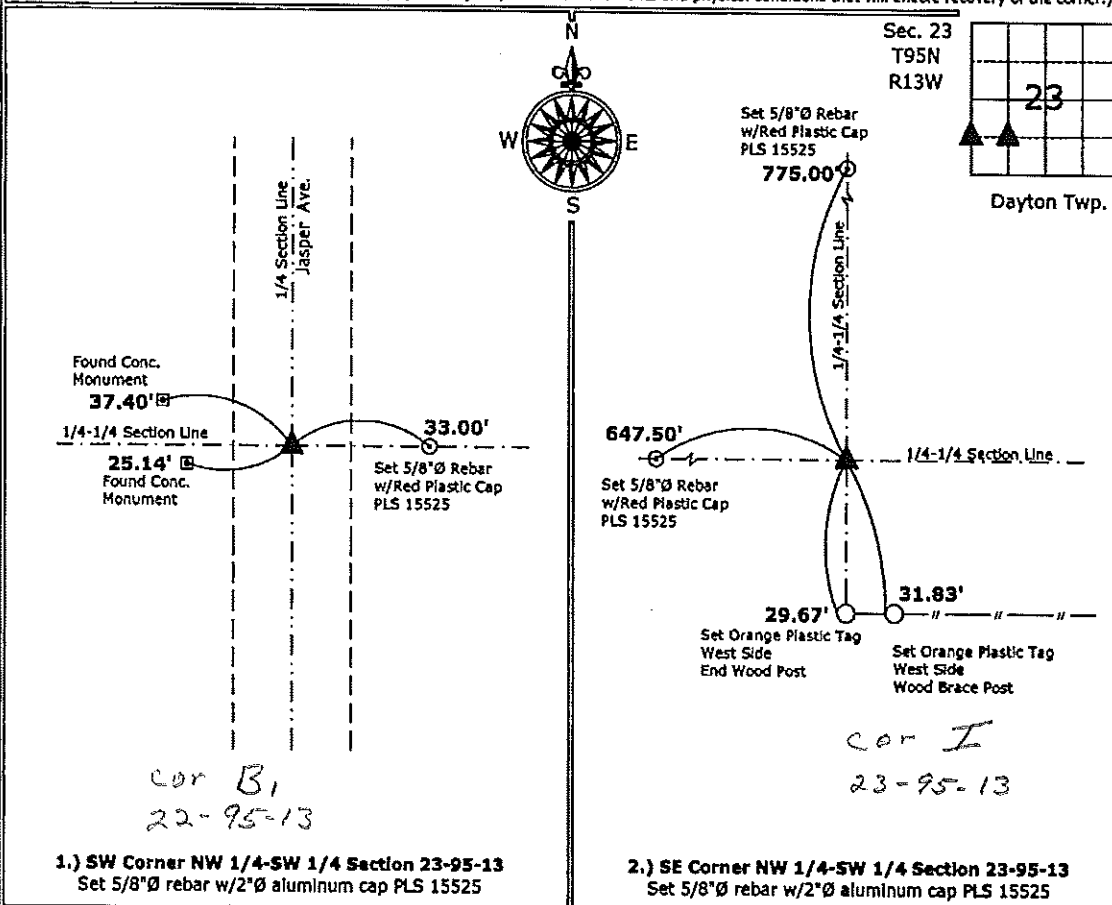

I hereby certify that this land surveying document was prepared and the related survey work was performed by me or under my direct personal supervision and that I am a duly licensed Land Surveyor under the laws of the State of Iowa.

Paul R. Herold 3-30-10
 Paul R. Herold Date:
 License number 15525
 My license renewal date is December 31, 2010.
 Sheets covered by this seal: Individual sheet only

List Corners to be Indexed			
Corners	Section	Twp.	Range
SW-NW-SW	23	95	13
SE-NW-SW	23	95	13

Project Number: 2010-026
 FB: Chickasaw County 2, Pgs. 35-38