

Chickasaw Co. Recorder
 Cindy Messersmith
 Fee Book 2010-0468
 04/02/2010 01140AM
 SCC SEC COR CERT
 Book: Page: # Pages: 1
 Total Fees: \$9.00

Herold - Reeks Surveying, 10 East Main Street, New Hampton, IA 50659, Ph. 641-394-2725, Fax. 641-394-2728

UNITED STATES PUBLIC LAND SURVEY CORNER CERTIFICATE

23

Land Survey Monuments situated in Section 25, Township 95 North, Range 13 West of the Fifth Principal Meridian, Chickasaw County, Iowa. 1.) Previously recorded in Doc. #2003-3497, in the County Recorder's office, 2.) Previously recorded in Bk. 150, Pg. 372 in the County Recorder's office.

This certificate is being prepared in compliance with Iowa Code Chapter 355.11 because:

{ There is no certificate on file for this corner.
 There are no longer three valid ties of record.
 There are changes to reference ties of record.
 There is change of monumentation of record.
 To clarify description of record monument (ties).


Monument Description and Remarks:

1.) **West 1/4 Corner:** Found 3/4"Ø rebar from information obtained from the previous Section Corner Certificate, the ties have changed and are being updated.

2.) **Northwest Corner:** Found 1/2"Ø rebar from information obtained from previous Section Corner Certification for Section 24-95-13, retying Corner to update ties & graphics.

PLAN - VIEW

(Show a minimum of three reference ties to durable physical objects, relevant monuments and physical conditions that will enable recovery of the corner.)

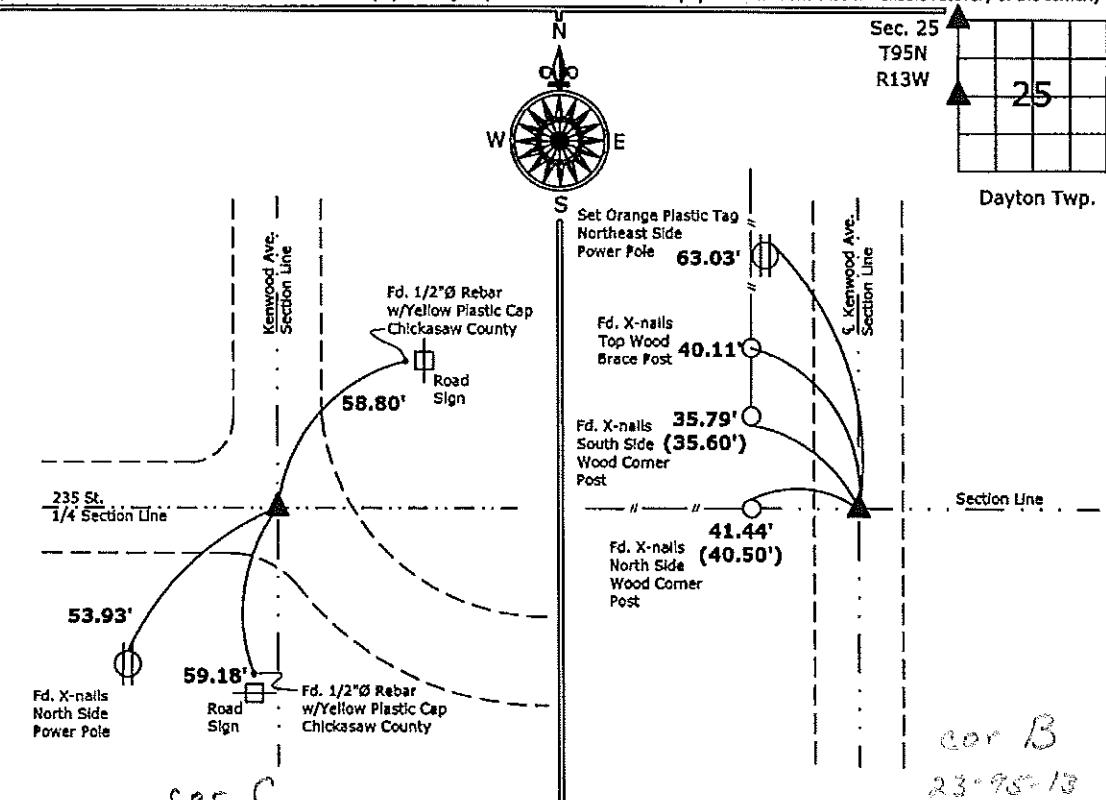

1.) West 1/4 Corner Section 25-95-13
 Found 3/4"Ø rebar

2.) Northwest Corner Section 25-95-13
 Found 1/2"Ø rebar



I hereby certify that this land surveying document was prepared and the related survey work was performed by me or under my direct personal supervision and that I am a duly licensed Land Surveyor under the laws of the State of Iowa.

Paul R. Herold 4-2-10

Paul R. Herold Date:

License number 15525

My license renewal date is December 31, 2010.

Sheets covered by this seal: Individual sheet only

List Corners to be Indexed			
Corners	Section	Twp.	Range
W 1/4	25	95	13
NW	25	95	13

Project Number: 2010-026

FB: Chickasaw County 2, Pgs. 35-38

2003 NOV 14 AM 9 29

CINDY MESSERSMITH
 COUNTY RECORDER

TeKIPPE ENGINEERING, P.C., 126 South Vine Street, West Union, Iowa 52175 Phone (563) 422-5131

UNITED STATES PUBLIC LAND SURVEY CORNER CERTIFICATE

OF

Land Survey Monuments situated in Section 25, Township 95 North, Range 13 West of the Fifth Principal Meridian, CHICKASAW County, Iowa. Previously recorded in none (book, page, document number, etc.)

(Show reason for preparing this certificate, the evidence and detailed procedures used in establishing the corner positions and monumentation found or placed.)


Monument Description and Remarks: W 1/4 Corner Section 25 T95N R13W: Found 3/4"Ø rebar with information obtained from the Chickasaw County Engineer's Office in Field Book Dayton Twp. Corner Ties, Corner 'C'.

S 1/4 Corner Section 25 T95N R13W: Set 1/2"Ø rebar w/2"Ø aluminum cap PLS 15525 by extending a line Easterly from the SE Corner through a Iowa D.O.T. ROW monument and intersecting a possession fence.

PLAN - VIEW


Project Number 03198.LS
 FB. 48K PG. 30-33

(Show a minimum of three reference ties to durable physical objects, relevant monuments and physical conditions that will enable recovery of the corner.)

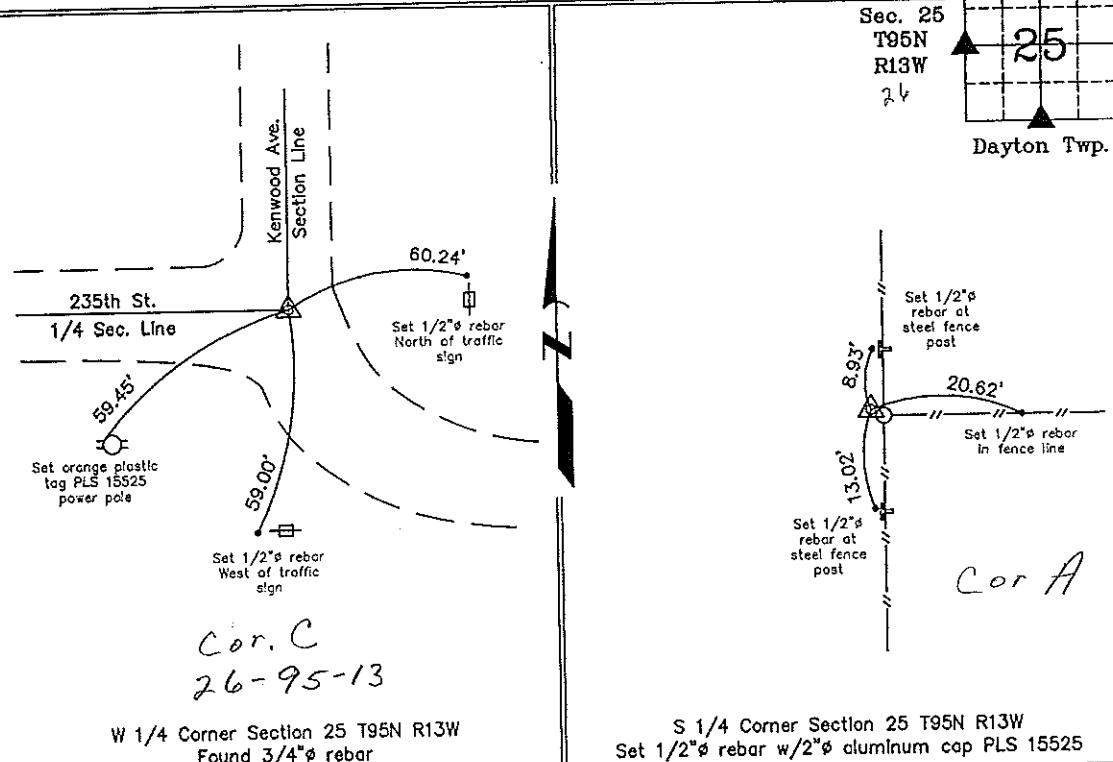

W 1/4 Corner Section 25 T95N R13W
 Found 3/4"Ø rebar

S 1/4 Corner Section 25 T95N R13W
 Set 1/2"Ø rebar w/2"Ø aluminum cap PLS 15525

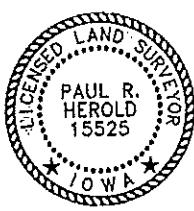

I hereby certify that this land surveying document was prepared and the related survey work was performed by me or under my direct personal supervision and that I am a duly licensed Land Surveyor under the laws of the State of Iowa.

Paul R. Herold 11-12-03

Date

License number 15525

My license renewal date is December 31, 2004.
 Sheets covered by this seal: Individual

List Corners to be Indexed

Corners	Section	Twp.	Range
W 1/4	25	95N	13W
S 1/4	25	95N	13W

Filed 12-15-03

X:\Section Corners\Sec. 25\25-95-13kw.dwg