

Instrument #: 2020-2411  
 10/23/2020 12:53:33 PM Total Pages: 1  
 SCC SECTION CORNER CERTIFICATES  
 Recording Fee: \$ 7.00  
 Shirley Troyna, Recorder, Chickasaw County Iowa

Prepared by: Erdman Engineering, P.C., 708 Commerce Drive, P.O. Box 246, Decorah, Iowa, (563)382-4194

UNITED STATES PUBLIC LAND SURVEY CORNER CERTIFICATE  
 OF

Land Survey Monuments situated in Section 35, Township 95 North, Range 13 West, of  
 the Fifth Principal Meridian, Chickasaw County, Iowa, Previously recorded in does not apply in the  
 County Recorder's Office.

Monument Description and Remarks:

This certificate is prepared in accordance with Section 355.11 of the Code of Iowa. No previous certificates have been filed for these corner locations.


**SW 1/16 Corner:** We found no record of the SW  $\frac{1}{16}$  Corner being set. We found no evidence of a monument in the field other than an existing fence line running east and west. We found the SW Corner, S  $\frac{1}{4}$  Corner, WSW  $\frac{1}{8}$  Corner, S  $\frac{1}{8}$  Corner, and W  $\frac{1}{8}$  Corner. We computed the location of the SSW  $\frac{1}{16}$  Corner on line and midway between the SW Corner and the S  $\frac{1}{4}$  Corner. We set a  $\frac{1}{2}$ " diameter steel bar with 1  $\frac{1}{2}$ " aluminum cap #11442 on line between the W  $\frac{1}{8}$  Corner and the SSW  $\frac{1}{16}$  Corner and in the existing fence line, as the SW  $\frac{1}{16}$  Corner of Section 35, Township 95 North, Range 13 West.

PLAN-VIEW


(NOT TO SCALE)

**SW 1/16 CORNER**

Set  $\frac{1}{2}$ " diameter steel  
 bar with 1  $\frac{1}{2}$ " aluminum  
 cap #11442

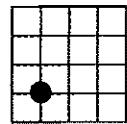

SECTION 35

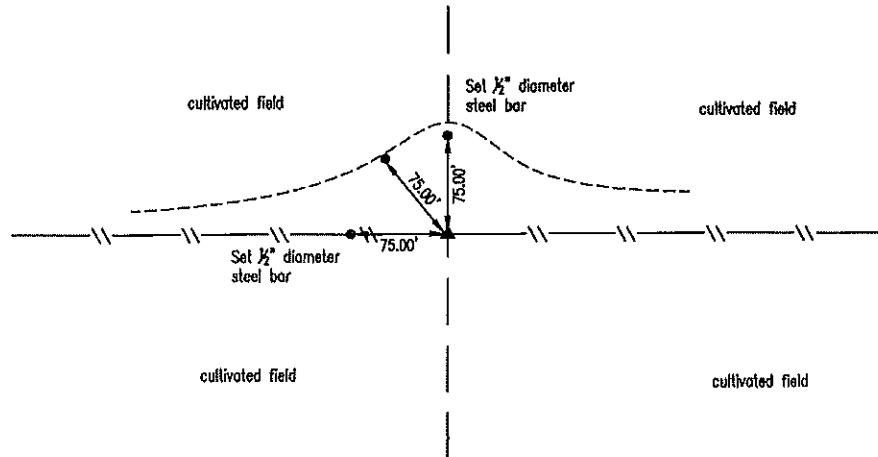

cultivated field

Set  $\frac{1}{2}$ " diameter  
 steel bar

cultivated field

Set  $\frac{1}{2}$ " diameter  
 steel bar

cultivated field

cultivated field



Cor I - 35-95-13

I hereby certify that this land surveying document was prepared and the related survey work was performed by me or under my direct personal supervision and that I am a duly licensed Land Surveyor under the laws of the State of Iowa.



Lindsay Erdman, P.E. & P.L.S.  
 Licensed Professional Land Surveyor  
 Iowa License Number 11442  
 My license renewal date is December 31, 2020  
 Pages or sheets covered by this seal: THIS SHEET ONLY

List Corner(s) to be Indexed

Corner(s)	Section	Township	Range
SW 1/16	35	95N	13W

**ERDMAN  
 ENGINEERING, P.C.**  
 CIVIL ENGINEERING & LAND SURVEYING  
 Decorah, Iowa