

Chickasaw Co. Recorder
Cindy Messersmith
Fee Book 2007-0974

05/14/2007 @11:14AM
SCC SEC COR CERT
Book: Page: # Pages: 1
Total Fees: \$7.00

Herold - Reicks Surveying, 25 1/2 East Main Street, Suite 204, New Hampton, IA 50659, Ph. 641-394-2725

UNITED STATES PUBLIC LAND SURVEY CORNER CERTIFICATE

Land Survey Monuments situated in:
Section 35, Township 95 North, Range 13 West of the Fifth Principal Meridian,
Chickasaw County, Iowa. Previously recorded in 1.} None 2.} None
in County Recorder's Office.


(Show reason for preparing this certificate, the evidence and detailed procedures used in establishing the corner positions and monumentation found or placed.)

Monument Description and Remarks:

- 1.) NW Corner SW 1/4-SE 1/4 Section 35-95-13, Set 1/2"Ø rebar w/2"Ø aluminum cap PLS 15525 midway and on line between the South 1/4 Corner and the calculated Center of the Section.
- 2.) NE Corner SE 1/4-SE 1/4 Section 35-95-13, Set 1/2"Ø rebar w/2"Ø aluminum cap PLS 15525 midway and on line between the West 1/4 Corner and the SE Corner of the Section.

PLAN - VIEW

(Show a minimum of three reference ties to durable physical objects, relevant monuments and physical conditions that will enable recovery of the corner.)

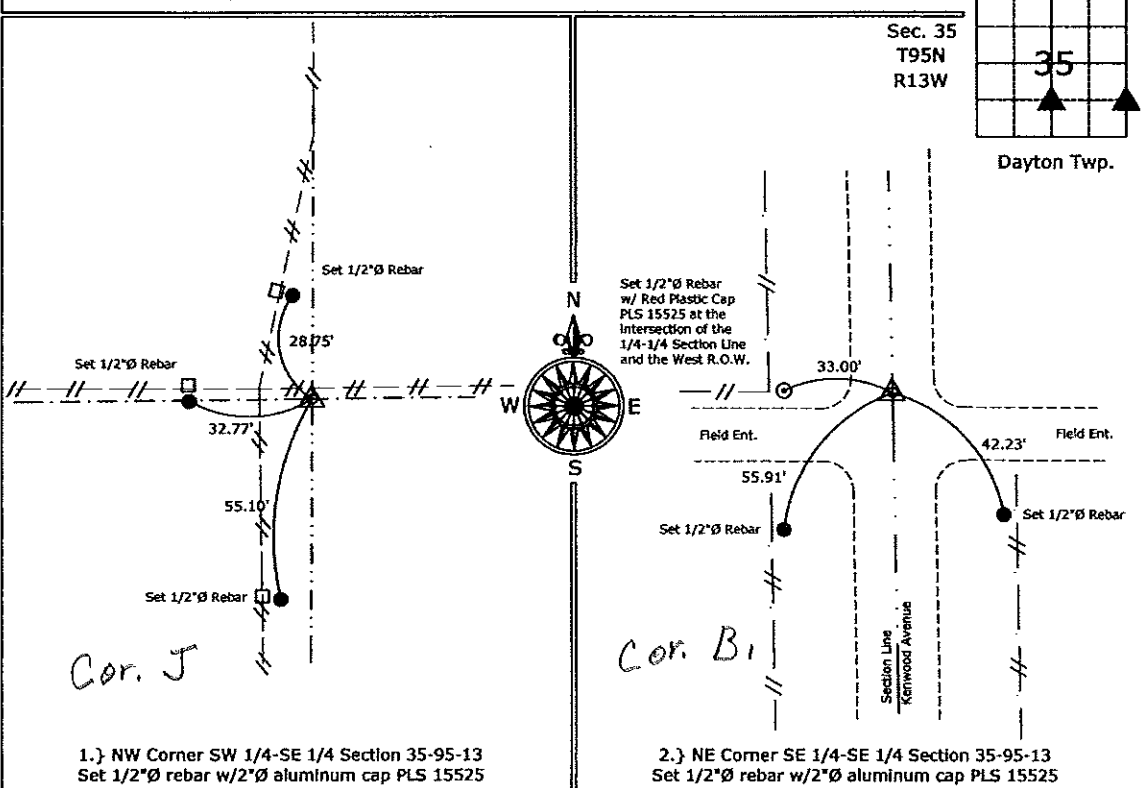

1.) NW Corner SW 1/4-SE 1/4 Section 35-95-13
Set 1/2"Ø rebar w/2"Ø aluminum cap PLS 15525

2.) NE Corner SE 1/4-SE 1/4 Section 35-95-13
Set 1/2"Ø rebar w/2"Ø aluminum cap PLS 15525



I hereby certify that this land surveying document was prepared and the related survey work was performed by me or under my direct personal supervision and that I am a duly licensed Land Surveyor under the laws of the State of Iowa.

Paul R. Herold 5-12-07
Paul R. Herold Date:

License number 15525
My license renewal date is December 31, 2008.
Sheets covered by this seal: Individual Sheet Only

List Corners to be Indexed			
Corners	Section	Twp.	Range
NW-SW-SE	35	95	13
NE-SE-SE	35	95	13

Project Number: 2007-033

FB: Chickasaw County 1, Pgs. 13-20

File: S:_Projects\2007-033\dwg\2007-031-032-033.dwg, 5/14/2007 8:50:12 AM