

Chickasaw Co. Recorder  
 Cindy Messersmith  
 Fee Book 2010-0466  
 04/02/2010 @0931AM  
 SCC SEC COR CERT  
 Book: Page: # Pages: 1  
 Total Fees: \$9.00

Herold - Racks Surveying, 10 East Main Street, New Hampton, IA 50659, Ph. 641-394-2725, Fax. 641-394-2718

### UNITED STATES PUBLIC LAND SURVEY CORNER CERTIFICATE

Land Survey Monuments situated in Section 25, Township 95 North, Range 13 West of the Fifth Principal Meridian, Chickasaw County, Iowa. 1.) Previously recorded in Bk. 153, Pg. 126 in the County Recorder's office, 2.) Previously not recorded in the County Recorder's office.

This certificate is being prepared in compliance with Iowa Code Chapter 355.11 because:

2.)  There is no certificate on file for this corner.  
 There are no longer three valid ties of record.  
 1.)  There are changes to reference ties of record.  
 There is change of monumentation of record.  
 To clarify description of record monument (ties).


#### Monument Description and Remarks:

1.) **Southwest Corner:** Found 5/8"Ø rebar from information obtained from the previous Section Corner Certificate, the culvert was replaced and all of the previous ties were missing.

2.) **Center of Section:** Set 5/8"Ø rebar w/2"Ø aluminum cap PLS 15525 at the intersection of the Quarter Section Lines.

### PLAN - VIEW

(Show a minimum of three reference ties to durable physical objects, relevant monuments and physical conditions that will enable recovery of the corner.)

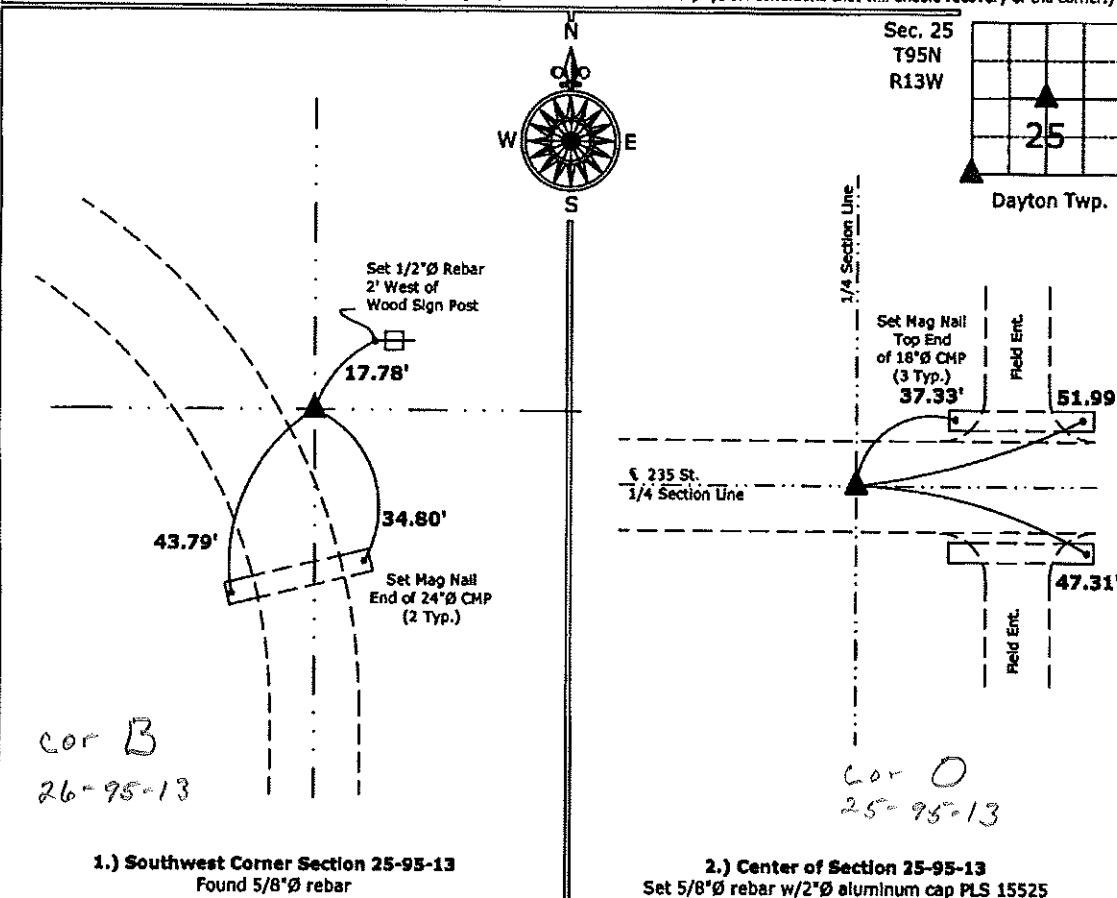

I hereby certify that this land surveying document was prepared and the related survey work was performed by me or under my direct personal supervision and that I am a duly licensed Land Surveyor under the laws of the State of Iowa.

*Paul R. Herold 3-30-10*

Paul R. Herold Date:

License number 15525

My license renewal date is December 31, 2010.  
 Sheets covered by this seal: Individual sheet only

#### List Corners to be Indexed

| Corners | Section | Twp. | Range |
|---------|---------|------|-------|
| SW      | 25      | 95   | 13    |
| CTR     | 25      | 95   | 13    |

Project Number: 2010-026

FB: Chickasaw County 2, Pgs. 35-38

Section 26-95-13  
As referred to in  
Eng. Tie Book

SLSI 9-90

UNITED STATES PUBLIC LAND SURVEY CORNER CERTIFICATE

OF

Land Survey Monuments situated in Section 36 26, Township 95 NORTH, Range 13 WEST, of the Fifth Principal Meridian, CHICKASAW County, Iowa. Previously recorded in NONE in County Recorder's Office.



(book, page, document number, etc.)  
(Show reason for preparing this certificate, the evidence and detailed procedures used in establishing the corner positions and monumentation found or placed.)

Monument Description and Remarks: NW CORNER, SECTION 36-T95N-R13W:  
Found 5/8" Iron Pin.

W 1/4 CORNER, SECTION 36-T95N-R13W: Found 3/4" Rebar.

PLAN - VIEW

(Show a minimum of three reference ties to durable physical objects, relevant monuments and physical conditions that will enable recovery of the corner.)

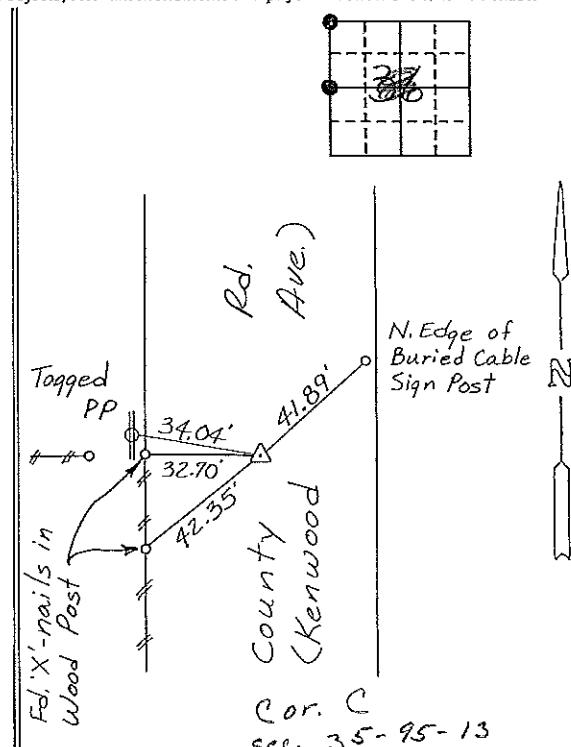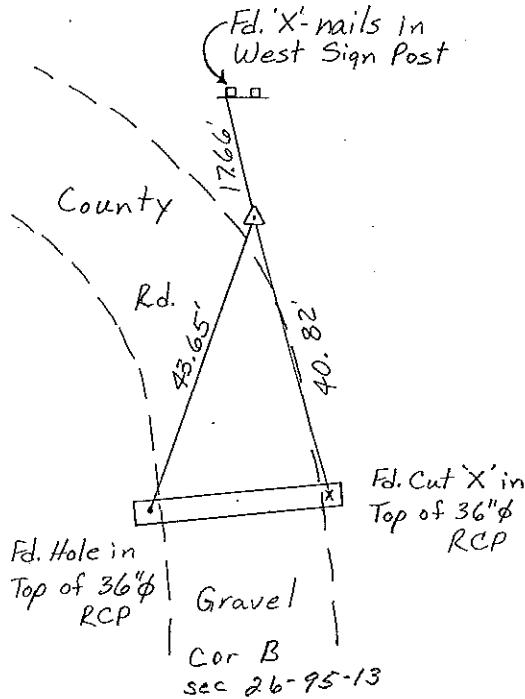


NW CORNER, SECTION 36-T95N-R13W

W 1/4 CORNER, SECTION 36-T95N-R13W

I hereby certify that the survey work was completed and this certificate was prepared by me or under my direct personal supervision and that I am a duly registered land surveyor under the laws of the state of Iowa.

Signature: Gary L. Casady  
Name typed or printed: Gary L. Casady  
Date: 10-5-93 Reg. No. 12532  
My Registration Expires December 31, 1994

SEAL

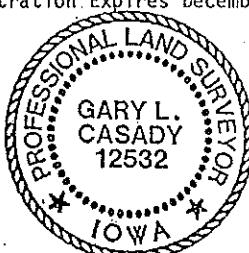

| Corners | List Corners to be Indexed | Section | Twp | Range              |
|---------|----------------------------|---------|-----|--------------------|
| NW      | 36                         | 95N     | 13W | Cor B sec 26-95-13 |
| W 1/4   | 36                         | 95N     | 13W | Cor C sec 35-95-13 |

*Placed in the Bush  
10/8/93  
JPM*

153-126

"County Engineer's Copy"