

Prepared by & Return to: Herold - Reicks Surveying, 10 East Main Street, New Hampton, IA 50659, Ph. 641-394-2725

UNITED STATES PUBLIC LAND SURVEY CORNER CERTIFICATE

Land Survey Monuments situated in Section 3, Township 95 North, Range 13 West of the Fifth Principal Meridian, Chickasaw County, Iowa. Previously recorded in Bk. , Pg. in the County Recorder's office.

This certificate is being prepared in compliance with Iowa Code Chapter 355.11 because:

- 1 & 2 There is no certificate on file for this corner.
 There are no longer three valid ties of record.
 There are changes to reference ties of record.
 There is change of monumentation of record.
 To clarify description of record monument (ties).


Monument Description and Remarks:

1.) **Center of Section:** Fd. 12" X 9" Granite Stone, Set 5/8"Ø Rebar w/2"Ø Alum. Cap PLS 155225 0.54' South of Stone as Witness. There are Fence Remnants running East, West and North of this Corner and all lead to the Stone, the actual corner is 40 feet South of the Theoretical Position, but does match all of the field evidence, therefore accepted the Stone as the correct Center of Section.

2.) **S 1/4 Corner:** Fd. Survey Mark Nail w/I.D.O.T. Stainless Steel Washer.
 Corner was recovered from information obtained from the Iowa Iowa Department of Transportation, As-Built Plans Project No. FR-18-7(31)--26-19, the previous Alum. Disk was replaced after an HMA Overlay Project.

PLAN - VIEW

(Show a minimum of three reference ties to durable physical objects, relevant monuments and physical conditions that will enable recovery of the corner.)

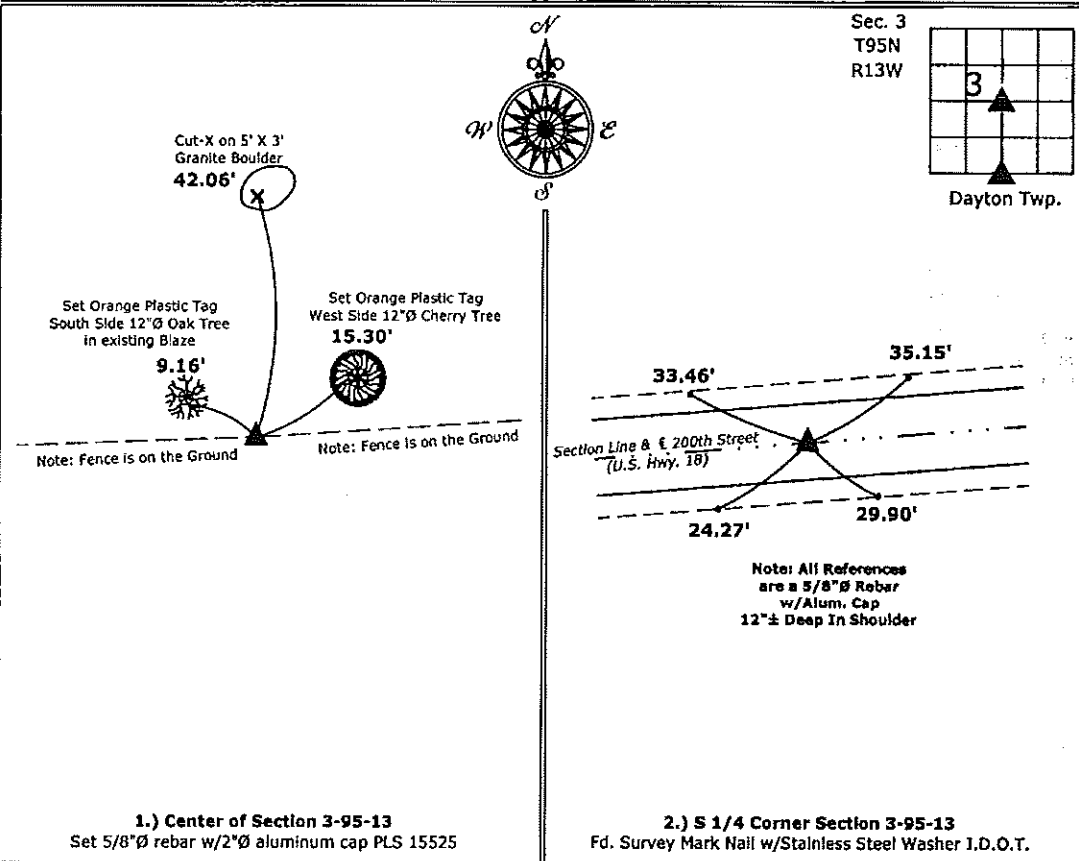

1.) **Center of Section 3-95-13**
 Set 5/8"Ø rebar w/2"Ø aluminum cap PLS 15525

2.) **S 1/4 Corner Section 3-95-13**
 Fd. Survey Mark Nail w/Stainless Steel Washer I.D.O.T.



I hereby certify that this land surveying document was prepared and the related survey work was performed by me or under my direct personal supervision and that I am a duly licensed Land Surveyor under the laws of the State of Iowa.
Paul R. Herold 7-8-14
 Paul R. Herold Date:
 License number 15525
 My license renewal date is December 31, 2014.
 Sheets covered by this seal: Individual sheet only

List Corners to be Indexed

Corners	Section	Twp.	Range
CTR	3	95	13
S 1/4	3	95	13

Project Number: 2014-045

FB: Chickasaw County 6, Pgs. 31-34

File: S:_CAD Projects\County Control Systems\CHICKASAW\CHICK-27\CHICK-27.dwg, 7/8/2014 10:38:54 AM