



Prepared by & Return to: Reicks Surveying, 10 East Main Street, New Hampton, IA 50659, Ph. 641-394-2725

United States Public Land Survey Corner Certificate

Land Survey Monument situated in
Section 6, Township 95 North, Range 13 West of the Fifth Principal Meridian, Chickasaw County, Iowa.
 Not on file in the County Recorder's office.

This certificate is being prepared in compliance
 with Iowa Code Chapter 355.11 because:


{ There is no certificate on file for this corner.
 There are no longer three valid ties of record.
 There are changes to reference ties of record.
 There is change of monumentation of record.
 To clarify description of record monument (ties).

Monument Description and Remarks:


Northeast Corner SE 1/4-NE 1/4: Set 1"Ø Bronze Survey Marker PLS 19211 online between the Northeast and East 1/4 Corners of said Section and at the Easterly extension of Possession line fence remnants from the West.

Plan View

(Show a minimum of three reference ties to durable physical objects, relevant monuments and physical conditions that will enable recovery of the corner.)

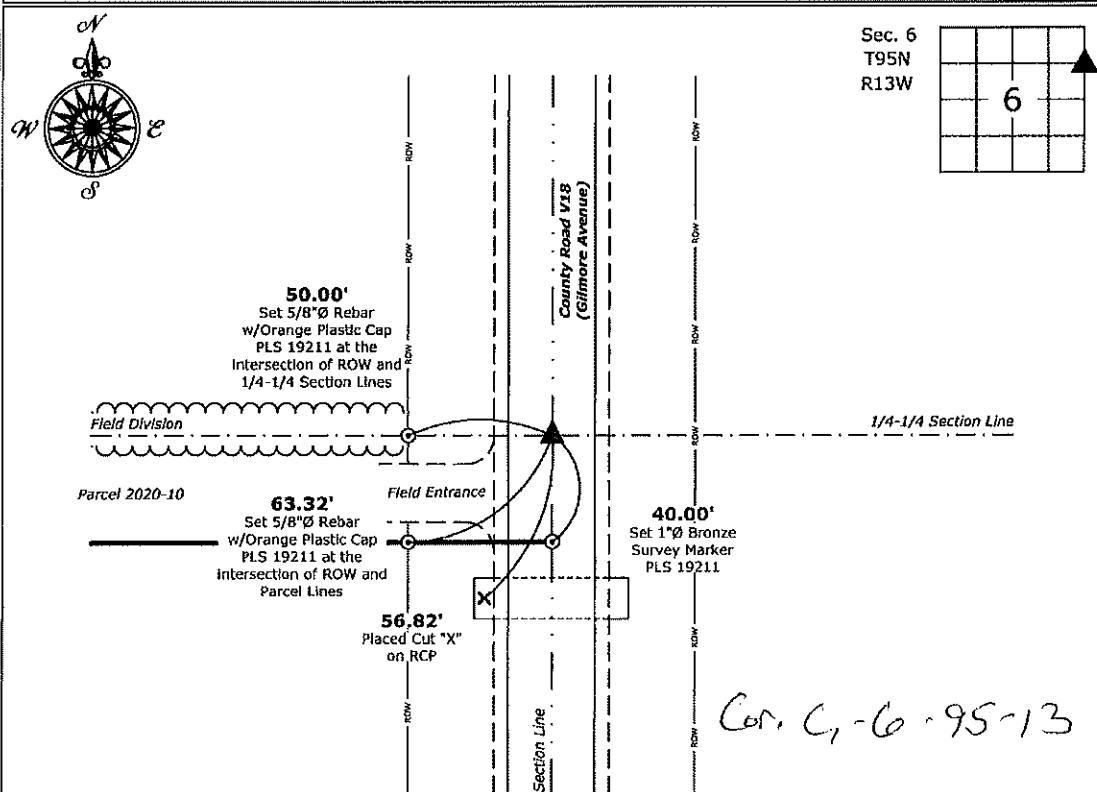

Northeast Corner SE 1/4-NE 1/4 of Section 6-95-13
 Set 1"Ø Bronze Survey Marker PLS 19211

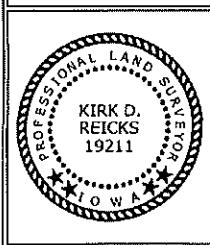

I hereby certify that this land surveying document
 was prepared and the related survey work was
 performed by me or under my direct personal
 supervision and that I am a duly licensed Land
 Surveyor under the laws of the State of Iowa.

Kirk D. Reicks 4-3-2020

Kirk D. Reicks
 License number 19211

My license renewal date is December 31, 2020.
 Sheets covered by this seal: Individual sheet only

List Corner to be Indexed

| Corner | Section | Twp. | Range |
|----------|---------|------|-------|
| NE-SE-NE | 6 | 95 | 13 |

Project Number: 2020-026

FB: Chickasaw 10, Pgs. 15-16