

Instr. Number: 2020-0794
 Recorded: 5/4/2020 at 4:15:28.0 PM
 Pages 1
 County Recording Fee: \$7.00
 Iowa E-Filing Fee: \$3.00
 Combined Fee: \$10.00
 Revenue Tax:
 Shirley Troyna RECORDER
 Chickasaw County, Iowa

Prepared by & Return to: Herold - Reicks Surveying, 10 East Main Street, New Hampton, IA 50659, Ph. 641-394-2725

United States Public Land Survey Corner Certificate

Land Survey Monument situated in
 Section 6, Township 95 North, Range 13 West of the Fifth Principal Meridian, Chickasaw County, Iowa.
 Not on file in the County Recorder's office.

This certificate is being prepared in compliance with Iowa Code Chapter 355.11 because:

- There is no certificate on file for this corner.
- There are no longer three valid ties of record.
- There are changes to reference ties of record.
- There is change of monumentation of record.
- To clarify description of record monument (ties).


Monument Description and Remarks:

SE Corner NW 1/4-SW 1/4 of Section 6-95-13: Fd. 4" X 6" X 6' Blue Granite Stone, Placed Cut-X on Top of Stone, Set 5/8"Ø Rebar w/2"Ø Alum. Cap PLS 155250.52' From Cut-X on SW Side of Stone.

Corner located in Vicinity of round Granite Stones, Stone is quarried and is 12" Long and accepted as True Corner, base on a Survey and Plat recorded in Book 110, Pg. 192.

Plan View

(Show a minimum of three reference ties to durable physical objects, relevant monuments and physical conditions that will enable recovery of the corner.)

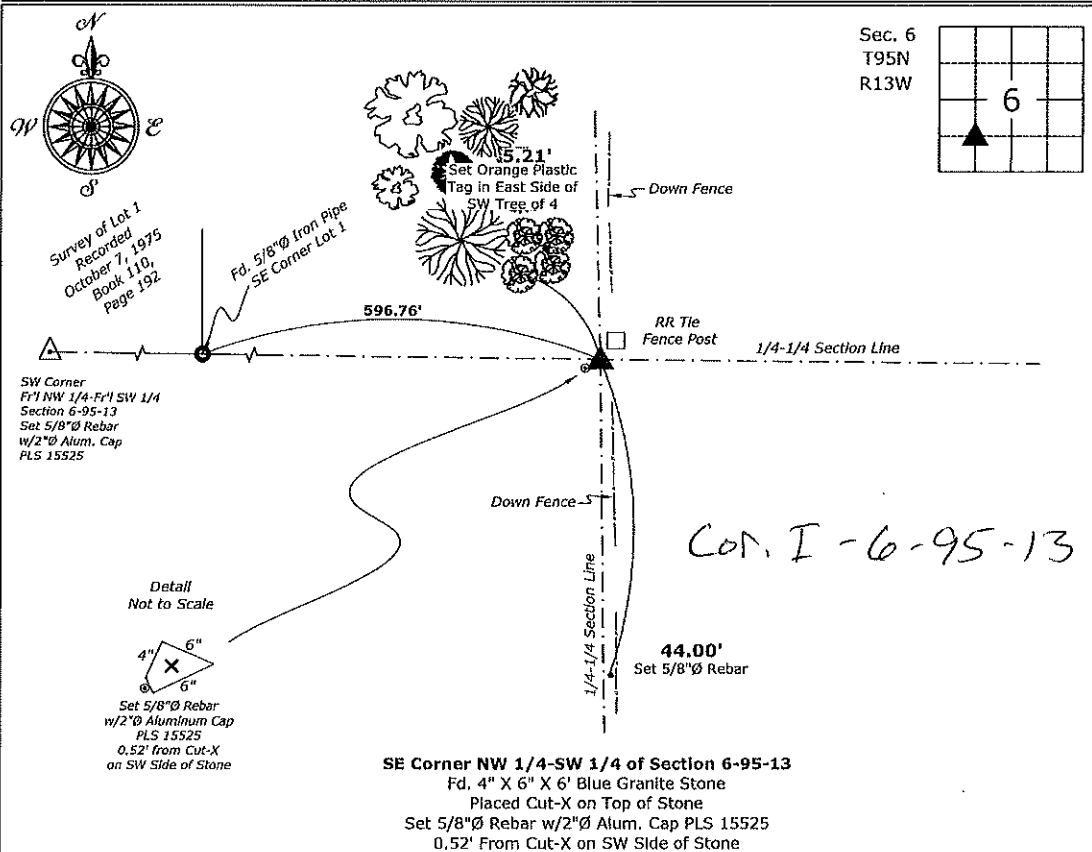

Cor. I-6-95-13

SE Corner NW 1/4-SW 1/4 of Section 6-95-13
 Fd. 4" X 6" X 6' Blue Granite Stone
 Placed Cut-X on Top of Stone
 Set 5/8"Ø Rebar w/2"Ø Alum. Cap PLS 15525
 0.52' From Cut-X on SW Side of Stone



I hereby certify that this land surveying document was prepared and the related survey work was performed by me or under my direct personal supervision and that I am a duly licensed Land Surveyor under the laws of the State of Iowa.

Paul R. Herold 5-4-20
 Paul R. Herold Date:
 License number 15525
 My license renewal date is December 31, 2020.
 Sheets covered by this seal: Individual sheet only

List Corner to be Indexed			
Corner	Section	Twp.	Range
SE-NW-SW	6	95	13
Project Number: 2020-039			
FB: Chickasaw County 10, Pg. 19			

File: S:\Projects - NHO\County Control Systems - NHO\CHICKASAW\CHICK-27\CHICK-27 - 2020.dwg, 5/4/2020 11:03:03 AM