

Herold - Reicks Surveying, 10 East Main Street, New Hampton, IA 50659, Ph. 641-394-2725, Fax. 641-394-2718

UNITED STATES PUBLIC LAND SURVEY CORNER CERTIFICATE

Land Survey Monuments situated in Section **6**, Township **95** North, Range **12** West of the Fifth Principal Meridian, **Chickasaw** County, Iowa. 1.) Previously recorded in Bk. 169, Pg. 71 in the County Recorder's office, 2.) Previously not recorded in the County Recorder's office.

This certificate is being prepared in compliance with Iowa Code Chapter 355.11 because:

- 2.) There is no certificate on file for this corner.
- There are no longer three valid ties of record.
- 1.) There are changes to reference ties of record.
- 1.) There is change of monumentation of record.
- To clarify description of record monument (ties).


Monument Description and Remarks:

1.) Southwest Corner NW 1/4-NE 1/4: Set 5/8"Ø rebar w/2"Ø aluminum cap PLS 15525 from information obtained from previous Section Corner Certificate.

2.) Northeast Corner SW 1/4-NW 1/4: Found 1/2"Ø rebar w/yellow plastic cap PLS 11442 matching position calculated from the M-P Subdivision geometry


PLAN - VIEW

(Show a minimum of three reference ties to durable physical objects, relevant monuments and physical conditions that will enable recovery of the corner.)

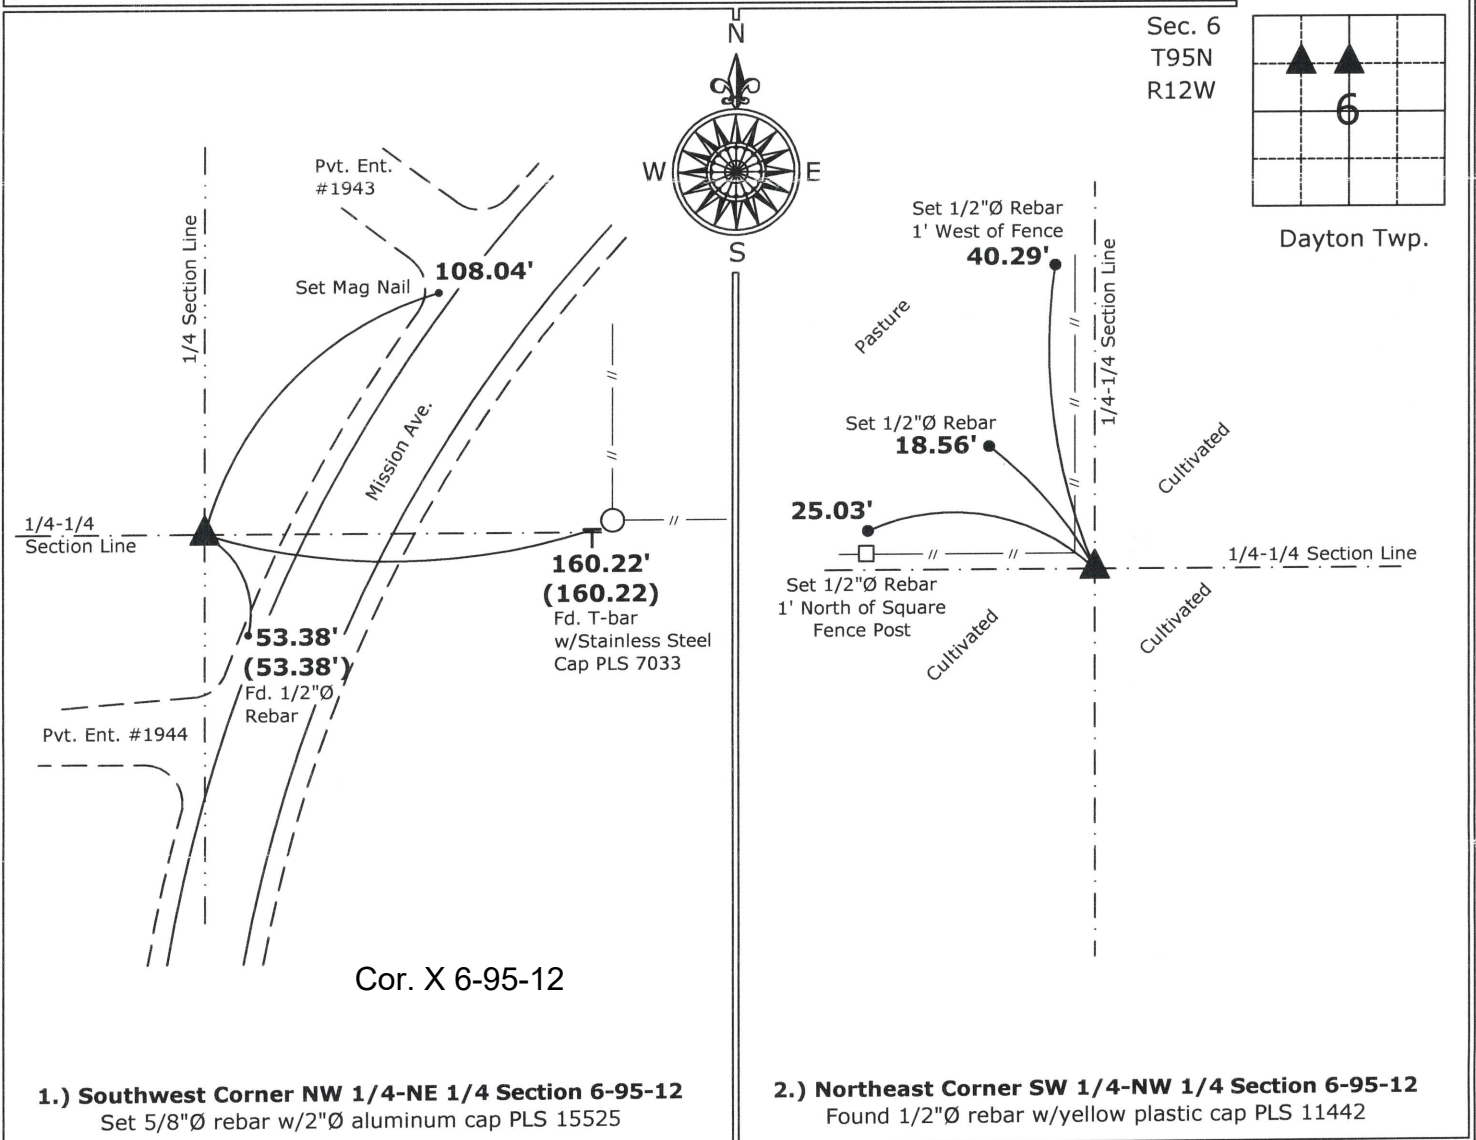

1.) Southwest Corner NW 1/4-NE 1/4 Section 6-95-12
Set 5/8"Ø rebar w/2"Ø aluminum cap PLS 15525

2.) Northeast Corner SW 1/4-NW 1/4 Section 6-95-12
Found 1/2"Ø rebar w/yellow plastic cap PLS 11442

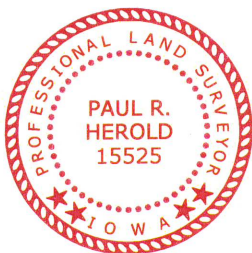

I hereby certify that this land surveying document was prepared and the related survey work was performed by me or under my direct personal supervision and that I am a duly licensed Land Surveyor under the laws of the State of Iowa.

Paul R. Herold 5-27-10
Paul R. Herold Date:

License number 15525
My license renewal date is December 31, 2010.
Sheets covered by this seal: Individual sheet only

List Corners to be Indexed			
Corners	Section	Twp.	Range
SW-NW-NE	6	95	12
NE-SW-NW	6	95	12
Project Number: 2010-055			
FB: Chickasaw County 3, Pgs.			